


WATER WELL PLUGGING RECORD Form WWC-5P KSA 82a-1212 ID NO.

| | | | | |
|--|---------------------------------|----------------------|---------------------------|---|
| 1 LOCATION OF WATER WELL: County: Lyon | Fraction SE ¼ SE ¼ SW ¼ NE ¼ | Section Number 11 | Township Number T 19 S | Range Number 10 <input checked="" type="checkbox"/> E <input type="checkbox"/> W |
|--|---------------------------------|----------------------|---------------------------|---|

| | |
|---|---|
| Street/Rural Address of Well Location; if unknown, distance & direction from nearest town or intersection: If at owner's address, check here <input checked="" type="checkbox"/> 574 W Hwy 50 | Global Positioning Systems (GPS) information: Latitude: <u>38.412694</u> (in decimal degrees) Longitude: <u>-96.267775</u> (in decimal degrees) Elevation: <u>1146 Feet</u> Horizontal Datum: <input checked="" type="checkbox"/> WGS84, <input type="checkbox"/> NAD83, <input type="checkbox"/> NAD27 Collection Method: <input type="checkbox"/> GPS unit (Make/Model: _____) <input checked="" type="checkbox"/> Digital Map/Photo, <input type="checkbox"/> Topographic Map, <input type="checkbox"/> Land Survey Est. Accuracy: <input type="checkbox"/> <3 m, <input type="checkbox"/> 3-5 m, <input type="checkbox"/> 5-15 m, <input type="checkbox"/> >15 m |
|---|---|

| | |
|--|--|
| 2 WATER WELL OWNER: Michael Gutierrez RR#, St. Address, Box #: 574 W Hwy 50 City, State ZIP Code: Emporia, KS 66801 | |
|--|--|

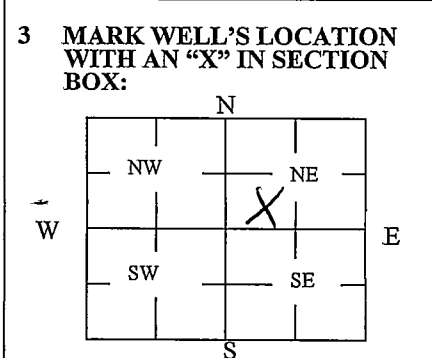

4 DEPTH OF WELL 20 ft.
 WELL'S STATIC WATER LEVEL 14 ft.
 WELL WAS USED AS:

| | | |
|--|---|---|
| <input checked="" type="checkbox"/> Domestic | <input type="checkbox"/> Public Water Supply | <input type="checkbox"/> Dewatering |
| <input type="checkbox"/> Irrigation | <input type="checkbox"/> Oil Field Water Supply | <input type="checkbox"/> Monitoring |
| <input type="checkbox"/> Feedlot | <input type="checkbox"/> Domestic (Lawn & Garden) | <input type="checkbox"/> Injection Well |
| <input type="checkbox"/> Industrial | <input type="checkbox"/> Air Conditioning | <input type="checkbox"/> Other _____ |

Was a chemical/bacteriological sample submitted to Department? Yes No

5 TYPE OF BLANK CASING USED:

| | | | | |
|--------------------------------|-----------------------------------|--|--|---|
| <input type="checkbox"/> Steel | <input type="checkbox"/> RMP (SR) | <input type="checkbox"/> Wrought | <input type="checkbox"/> Fiberglass | <input checked="" type="checkbox"/> Other (Specify below) |
| <input type="checkbox"/> PVC | <input type="checkbox"/> ABS | <input type="checkbox"/> Asbestos-Cement | <input type="checkbox"/> Concrete Tile | <u>Limestone Rock</u> |

Blank casing diameter 32 in. Was casing pulled? Yes No If yes, how much 5 Feet
 Casing height above or below land surface 60 in.

6 GROUT PLUG MATERIAL: Neat cement Cement grout Bentonite Other Flowable Fill

Grout Plug Intervals: From 0 ft. to 13 ft., From _____ ft. to _____ ft., From _____ ft. to _____ ft.

What is the nearest source of possible contamination:

| | | | |
|---|---|---|---|
| <input type="checkbox"/> Septic tank | <input type="checkbox"/> Seepage pit | <input type="checkbox"/> Fuel storage | <input checked="" type="checkbox"/> Other (specify below) |
| <input type="checkbox"/> Sewer lines | <input type="checkbox"/> Pit privy | <input type="checkbox"/> Fertilizer storage | <u>Pond</u> |
| <input type="checkbox"/> Watertight sewer lines | <input type="checkbox"/> Sewage lagoon | <input type="checkbox"/> Insecticide storage | |
| <input type="checkbox"/> Lateral lines | <input type="checkbox"/> Feedyard | <input type="checkbox"/> Abandoned water well | Direction from well? <u>WNW</u> |
| <input type="checkbox"/> Cess pool | <input type="checkbox"/> Livestock pens | <input type="checkbox"/> Oil well/Gas well | How many feet? <u>220</u> |

| FROM | TO | PLUGGING MATERIALS | FROM | TO | PLUGGING MATERIALS |
|------|----|-----------------------------|------|----|--------------------|
| 0 | 13 | Flowable Fill | | | |
| 13 | 20 | 3/4" Clean Rock (Limestone) | | | |
| | | | | | |
| | | | | | |
| | | | | | |
| | | | | | |

7 CONTRACTOR'S OR LANDOWNER'S CERTIFICATION: This water well was plugged under my jurisdiction and was completed on (mo/day/year) 11/17/21 and this record is true to the best of my knowledge and belief. Kansas Water Well Contractor's License No. NA. This Water Well Record was completed on (mo/day/year) 11/17/21 under the business name of KDOT by (signature) Dustin Hardin