


1	LOCATION OF WATER WELL:	Fraction	Section Number	Township Number	Range Number
	County: Lyon	SW 1/4 SE 1/4 NE 1/4	10	19	11E

Distance and direction from nearest town or city street address of well if located within city?
 1206 Highland

2 WATER WELL OWNER: ESU Endowment Association

RR#, St. Address, Box #: 1200 Commercial Board of Agriculture, Division of Water Resources
 City, State, ZIP Code : Emporia KS 66801 Application Number:

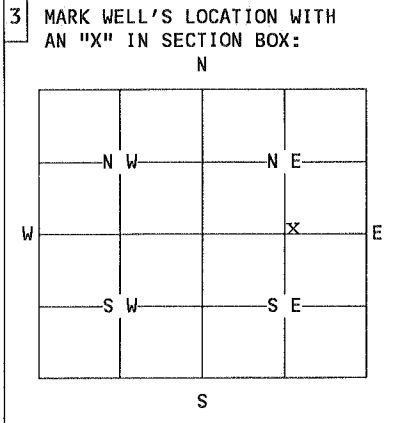

4 DEPTH OF WELL.....6.....ft.
 WELL'S STATIC WATER LEVEL.....3.....ft.

WELL WAS USED AS:

<input type="checkbox"/> Domestic	<input type="checkbox"/> Public Water Supply	<input type="checkbox"/> Dewatering
<input type="checkbox"/> Irrigation	<input type="checkbox"/> Oil Field Water Supply	<input type="checkbox"/> Monitoring Well
<input type="checkbox"/> Feedlot	<input type="checkbox"/> Lawn and Garden Only	<input type="checkbox"/> Injection Well
<input type="checkbox"/> Industrial	<input type="checkbox"/> Air Conditioning	<input type="checkbox"/> Other.....

Was a chemical/bacteriological sample submitted to Department? Yes....No..
 If yes, mo/day/yr sample was submitted.....

Water Well Disinfected: Yes..... No...

5 TYPE OF BLANK CASING USED:

1 Steel	3 RMP (SR)	5 Wrought	7 Fiberglass	9 Other (specify below)
2 PVC	4 ABS	6 Asbestos-Cement	8 Concrete Tile	brick.wall.....

Blank casing diameter....4.8....in. Was casing pulled? Yes.... No..... If yes, how much.all.3!...
 Casing height above or below land surface.....0....in.

6 GROUT PLUG MATERIAL: 1 Neat cement 2 Cement grout 3 Bentonite 4 Other...clay.....

Grout Plug Intervals: From....0ft. to....3ft., From.....ft. toft., From..... to.....ft.

What is the nearest source of possible contamination:

1 Septic tank	6 Seepage pit	11 Fuel storage	16 Other (specify below)
2 Sewer lines	7 Pit privy	12 Fertilizer storage
<input checked="" type="checkbox"/> Watertight sewer lines	8 Sewage lagoon	13 Insecticide storage	
4 Lateral lines	9 Feedyard	14 Abandoned water well	
5 Cess Pool	10 Livestock pens	15 Oil well/Gas well	

Direction from well? How many feet?

FROM	TO	PLUGGING MATERIALS
0	3	clay
3	6	sand

We believe this was a cistern due to its shape and water level.

7 CONTRACTOR'S OR LANDOWNER'S CERTIFICATION: This water well was plugged under my jurisdiction and was completed on (mo/day/year)..... and this record is true to the best of my knowledge and belief. Kansas Water Well Contractor's License No. This Water Well Record was completed on (mo/day/year)7/26/95..... under the business name of ESU Endowment Association..... by (signature) *ESU Foundation*.....

INSTRUCTIONS: Use typewriter or ball point pen. Please press firmly and print clearly. Please fill in blanks, underline or circle the correct answers. Send top three copies to Kansas Department of Health and Environment, Bureau of Water, Topeka, Kansas 66620-0001. Telephone: 913/296-3565. Send one to Water Well Owner and retain one for your records.