


1 LOCATION OF WATER WELL:	Fraction	Section Number	Township Number	Range Number
County: Lyon	C 1/4 NW 1/4 SE 1/4	14	T 19S S	R 11E E/W

Distance and direction from nearest town or city street address of well if located within city?  
 From 6th & Weaver Streets 1 mile south 1/4 mile west south into

2 WATER WELL OWNER: N.F. Wilson  
 RR#, St. Address, Box # : 1503 E. Logan Board of Agriculture, Division of Water Resource  
 City, State, ZIP Code : Emporia, Kansas 66801 Application Number:

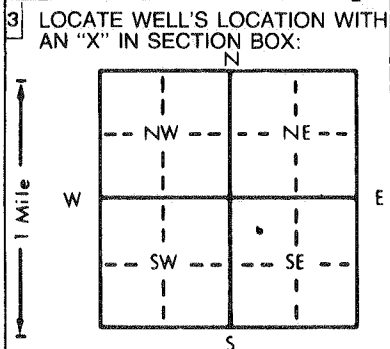

4 DEPTH OF COMPLETED WELL: 93' ft. ELEVATION: . . . . .

Depth(s) Groundwater Encountered 1. . . . . ft. 2. . . . . ft. 3. . . . . ft.

WELL'S STATIC WATER LEVEL 20' ft. below land surface measured on mo/day/yr 9-26-95

Pump test data: Well water was . . . . . ft. after . . . . . hours pumping . . . . . gpm

Est. Yield . . . . . gpm: Well water was . . . . . ft. after . . . . . hours pumping . . . . . gpm

Bore Hole Diameter: 9 1/2 in. to 93 ft., and . . . . . in. to . . . . . ft.

WELL WATER TO BE USED AS:

5 Public water supply	8 Air conditioning	11 Injection well
1 Domestic	3 Feedlot	6 Oil field water supply
2 Irrigation	4 Industrial	7 Lawn and garden only
		9 Dewatering
		10 Monitoring well
		12 Other (Specify below)

Windmill

Was a chemical/bacteriological sample submitted to Department? Yes . . . . . No ; If yes, mo/day/yr sample was submitted

Water Well Disinfected? Yes  No

5 TYPE OF BLANK CASING USED:

1 Steel	3 RMP (SR)	5 Wrought iron	8 Concrete tile	CASING JOINTS: Glued <input checked="" type="checkbox"/> Clamped . . . . .
2 PVC	4 ABS	6 Asbestos-Cement	9 Other (specify below)	Welded . . . . .
		7 Fiberglass		Threaded . . . . .

Blank casing diameter 5 in. to 40 ft., Dia . . . . . in. to . . . . . ft., Dia . . . . . in. to . . . . . ft.

Casing height above land surface 24 in., weight . . . . . lbs./ft. Wall thickness or gauge No. SDR25

TYPE OF SCREEN OR PERFORATION MATERIAL:

1 Steel	3 Stainless steel	5 Fiberglass	8 RMP (SR)	10 Asbestos-cement
2 Brass	4 Galvanized steel	6 Concrete tile	9 ABS	11 Other (specify)
				12 None used (open hole)

SCREEN OR PERFORATION OPENINGS ARE:

1 Continuous slot	3 Mill slot	5 Gauzed wrapped	8 Saw cut	11 None (open hole)
2 Louvered shutter	4 Key punched	6 Wire wrapped	9 Drilled holes	
		7 Torch cut	10 Other (specify)	

SCREEN-PERFORATED INTERVALS: From 40 ft. to 93 ft., From . . . . . ft. to . . . . . ft., From . . . . . ft. to . . . . . ft.

GRAVEL PACK INTERVALS: From 20 ft. to 93 ft., From . . . . . ft. to . . . . . ft., From . . . . . ft. to . . . . . ft.

6 GROUT MATERIAL: 1 Neat cement 2 Cement grout 3 Bentonite 4 Other

Grout Intervals: From 4 ft. to 20 ft., From . . . . . ft. to . . . . . ft., From . . . . . ft. to . . . . . ft.

What is the nearest source of possible contamination:

1 Septic tank	4 Lateral lines	7 Pit privy	10 Livestock pens	14 Abandoned water well
2 Sewer lines	5 Cess pool	8 Sewage lagoon	11 Fuel storage	15 Oil well/Gas well
3 Watertight sewer lines	6 Seepage pit	9 Feedyard	12 Fertilizer storage	16 Other (specify below)
			13 Insecticide storage	

Direction from well?		LITHOLOGIC LOG	How many feet?		PLUGGING INTERVALS
FROM	TO		FROM	TO	
0	15	Soil & Clay			
15	20	Course river gravel			
20	25	Fine sand			
25	40	Shale & clay			
40	30	Lime			
80	93	Shale			

7 CONTRACTOR'S OR LANDOWNER'S CERTIFICATION: This water well was (1) constructed, (2) reconstructed, or (3) plugged under my jurisdiction and was completed on (mo/day/year) 9-26-95 and this record is true to the best of my knowledge and belief. Kansas Water Well Contractor's License No. 171 This Water Well Record was completed on (mo/day/yr) 9-27-95 under the business name of G & S Drilling, Inc. by (signature)

INSTRUCTIONS: Use typewriter or ball point pen. PLEASE PRESS FIRMLY and PRINT clearly. Please fill in blanks, underline or circle the correct answers. Send top three copies to Kansas Department of Health and Environment, Bureau of Water, Topeka, Kansas 66620-0001. Telephone: 913-296-5545. Send one to WATER WELL OWNER and retain one for your records.