


1 LOCATION OF WATER WELL: County: **LYON** Fraction: **C-SE 1/4 SE 1/4 SE 1/4** Section Number: **12** Township Number: **T 19 S** Range Number: **R 11 EW**

Distance and direction from nearest town or city street address of well if located within city?  
**N-SIDE OLD H4 SD APPROX 1 MI E OF EMPORIA**

2 WATER WELL OWNER: **MRS WM. GENTNER**  
 RR#, St. Address, Box #: **901 PEYTON EMPORIA KS 66801**  
 City, State, ZIP Code: \_\_\_\_\_  
 Board of Agriculture, Division of Water Resource Application Number: \_\_\_\_\_

3 LOCATE WELL'S LOCATION WITH AN "X" IN SECTION BOX:

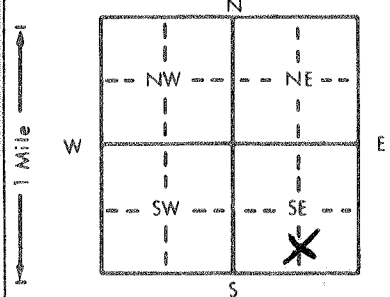

4 DEPTH OF COMPLETED WELL: **\* 26** ft. ELEVATION: \_\_\_\_\_  
 Depth(s) Groundwater Encountered: **\* UNKNOWN** ft. 2. \_\_\_\_\_ ft. 3. \_\_\_\_\_ ft.  
 WELL'S STATIC WATER LEVEL: **\* 1** ft. below land surface measured on mo/day/yr: **12 01 97**

Pump test data: Well water was **NA** ft. after \_\_\_\_\_ hours pumping \_\_\_\_\_ gpm  
 Est. Yield: **NA** gpm; Well water was \_\_\_\_\_ ft. after \_\_\_\_\_ hours pumping \_\_\_\_\_ gpm  
 Bore Hole Diameter: **UNKNOWN** ft., and \_\_\_\_\_ in. to \_\_\_\_\_ ft.

WELL WATER TO BE USED AS:  
 1 Domestic  3 Feedlot  6 Oil field water supply  9 Dewatering  12 Other (Specify below)  
 2 Irrigation  4 Industrial  7 Lawn and garden only  10 Monitoring well

Was a chemical/bacteriological sample submitted to Department? Yes \_\_\_\_\_ No ; If yes, mo/day/yr sample was submitted **LYON CO HEALTH DEPT.** Water Well Disinfected? Yes  No \_\_\_\_\_

5 TYPE OF BLANK CASING USED:  
 1 Steel  3 RMP (SR)  6 Asbestos-Cement  9 Other (specify below) \_\_\_\_\_  
 2 **PVC**  4 ABS  7 Fiberglass  \_\_\_\_\_  
 Blank casing diameter: **4 (OD)** in. to **-2** ft., Dia \_\_\_\_\_ in. to \_\_\_\_\_ ft., Dia \_\_\_\_\_ in. to \_\_\_\_\_ ft.  
 Casing height above land surface: **84** in., weight **80** lbs./ft. Wall thickness or gauge No. \_\_\_\_\_

TYPE OF SCREEN OR PERFORATION MATERIAL:  
 1 Steel  3 Stainless steel  5 Fiberglass  8 RMP (SR)  11 Other (specify) \_\_\_\_\_  
 2 Brass  4 Galvanized steel  6 Concrete tile  9 ABS  12 None used (open hole) \_\_\_\_\_


SCREEN OR PERFORATION OPENINGS ARE:  
 1 Continuous slot  3 Mill slot  5 Gauzed wrapped  8 **Saw cut**  11 None (open hole) \_\_\_\_\_  
 2 Louvered shutter  4 Key punched  6 Wire wrapped  9 Drilled holes  \_\_\_\_\_  
 7 Torch cut  10 Other (specify) \_\_\_\_\_

SCREEN-PERFORATED INTERVALS: From **\* -2** ft. to **20** ft., From \_\_\_\_\_ ft. to \_\_\_\_\_ ft.  
 From \_\_\_\_\_ ft. to \_\_\_\_\_ ft., From \_\_\_\_\_ ft. to \_\_\_\_\_ ft.  
 GRAVEL PACK INTERVALS: From **-2** ft. to **20** ft., From \_\_\_\_\_ ft. to \_\_\_\_\_ ft.  
 From \_\_\_\_\_ ft. to \_\_\_\_\_ ft., From \_\_\_\_\_ ft. to \_\_\_\_\_ ft.

6 GROUT MATERIAL: 1 Neat cement  2 Cement grout  3 **Bentonite**  4 Other \_\_\_\_\_  
 Grout Intervals: From **7.5** ft. to **-2** ft., From \_\_\_\_\_ ft. to \_\_\_\_\_ ft., From \_\_\_\_\_ ft. to \_\_\_\_\_ ft.

What is the nearest source of possible contamination:  
 1 Septic tank  4 Lateral lines  7 Pit privy  10 Livestock pens  14 Abandoned water well   
 2 Sewer lines  5 Cess pool  8 Sewage lagoon  11 Fuel storage  15 Oil well/Gas well   
 3 Watertight sewer lines  6 Seepage pit  9 Feedyard  12 Fertilizer storage  16 Other (specify below) **HOUSE GARBAGE**   
 13 Insecticide storage

Direction from well? **SW** **100-200'** how many feet? **SOLVENTS - BATTERIES**

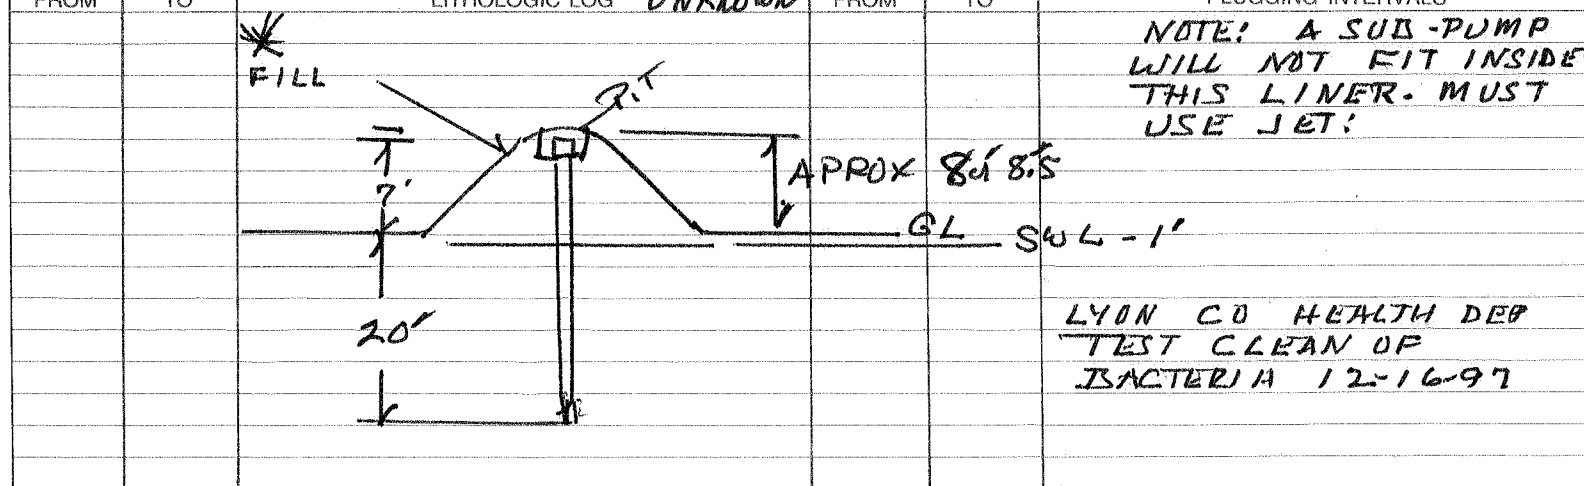

7 CONTRACTOR'S OR LANDOWNER'S CERTIFICATION: This water well was (1) constructed, (2) **reconstructed** or (3) plugged under my jurisdiction and was completed on (mo/day/year) **12 01 97** and this record is true to the best of my knowledge and belief. Kansas Water Well Contractor's License No. **479** This Water Well Record was completed on (mo/day/yr) **12 16 97** under the business name of **ERBERTS DRILLING** by (signature) \_\_\_\_\_