


1 LOCATION OF WATER WELL: County: Lyon Fraction: NW 1/4 NE 1/4 NW 1/4 Section Number: 15 Township Number: T 19 S Range Number: R 11 EW

Distance and direction from nearest town or city street address of well if located within city? 301 W. 6th Ave., Emporia, Kansas

2 WATER WELL OWNER: Genes Quik Lube RR#, St. Address, Box #: 141 Road 180 City, State, ZIP Code: Emporia, Kansas 66801 Board of Agriculture, Division of Water Resources Application Number:

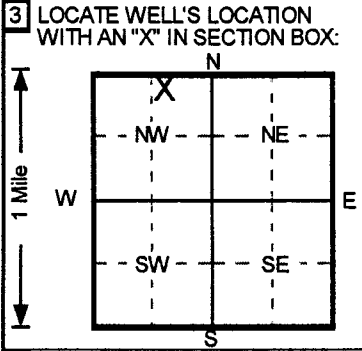

3 LOCATE WELL'S LOCATION WITH AN "X" IN SECTION BOX: 4 DEPTH OF COMPLETED WELL: 35 ft. ELEVATION: 1139.88 ft. WELL'S STATIC WATER LEVEL: 26.93 ft. below land surface measured on 9-11-98. Pump test data: Well water was NA ft. after NA hours pumping. Est. Yield NA gpm. Bore Hole Diameter 8 in. to 35 ft. WELL WATER TO BE USED AS: 10 Monitoring well. Was a chemical/bacteriological sample submitted? Yes. Water Well Disinfected? Yes.

5 TYPE OF BLANK CASING USED: 2 PVC. 5 Wrought iron. 8 Concrete tile. CASING JOINTS: Threaded. Blank casing diameter 2 in. to 25 ft. Dia. Casing height above land surface -4.44 in., weight Sch 40 lbs./ft. Wall thickness or gauge No. TYPE OF SCREEN OR PERFORATION MATERIAL: 7 PVC. 10 Asbestos-cement. SCREEN OR PERFORATION OPENINGS ARE: 3 Mill slot. 5 Gauzed wrapped. 8 Saw cut. 11 None (open hole). SCREEN-PERFORATED INTERVALS: From 25 ft. to 35 ft. GRAVEL PACK INTERVALS: From 23 ft. to 35 ft.

6 GROUT MATERIAL: 2 Cement grout. 3 Bentonite. 4 Other. Grout Intervals: From 0 ft. to 21 ft., From 21 ft. to 23 ft. What is the nearest source of possible contamination: 16 Other (specify below) Former Tank Basin. Direction from well? West. How many feet? 100.

Table with columns: FROM, TO, LITHOLOGIC LOG, FROM, TO, PLUGGING INTERVALS. Rows show lithology from 0 to 35 feet depth: Clay, Brown; Clay, Gray; Clay, Medium Brown.

7 CONTRACTOR'S OR LANDOWNER'S CERTIFICATION: This water well was (1) constructed, (2) reconstructed, or (3) plugged under my jurisdiction and was completed on (mo/day/year) 9/10/98 and this record is true to the best of my knowledge and belief. Kansas Water Well Contractor's License No. 527. This Water Well Record was completed on (mo/day/yr) 10/1/98 under the business name of GeoCore Services, Inc. by (signature) Dale Roll.

OFFICE USE ONLY T R EM SEC 1/4 1/4