


#2

1 LOCATION OF WATER WELL: Fraction NW 1/4 NE 1/4 NW 1/4 Section Number 15 Township Number T 19 S Range Number R 11 C/W
 County: Lyon

Distance and direction from nearest town or city street address of well if located within city?
 602 State Street, Emporia, KS

2 WATER WELL OWNER: DHE - Time 3 Materials
 RR#, St. Address, Box #: Town 3 Country #30
 City, State, ZIP Code: 43-056-0057
 Board of Agriculture, Division of Water Resources
 Application Number:

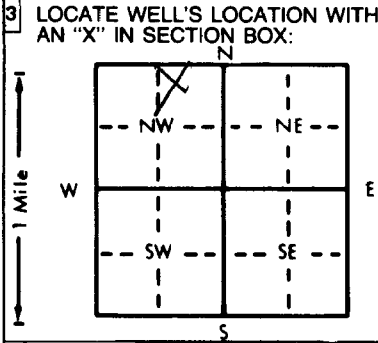

4 DEPTH OF COMPLETED WELL: 13.5 ft. ELEVATION:
 Depth(s) Groundwater Encountered 1. 2.5 ft. 2. ft. 3. ft.
 WELL'S STATIC WATER LEVEL: NA ft. below land surface measured on mo/day/yr: NA
 Pump test data: Well water was ... ft. after ... hours pumping ... gpm
 Est. Yield ... gpm: Well water was ... ft. after ... hours pumping ... gpm
 Bore Hole Diameter: 6.25 I.D.H.S.B. 13.5 ft. and ... in. to ... ft.
 WELL WATER TO BE USED AS:
 5 Public water supply 8 Air conditioning 11 Injection well
 1 Domestic 3 Feedlot 6 Oil field water supply 9 Dewatering
 2 Irrigation 4 Industrial 7 Lawn and garden only 10 Monitoring well
 12 Other (Specify below): Extraction
 Was a chemical/bacteriological sample submitted to Department? Yes.....No.....; If yes, mo/day/yr sample was submitted
 Water Well Disinfected? Yes No

5 TYPE OF BLANK CASING USED:
 1 Steel 3 RMP (SR) 5 Wrought iron 8 Concrete tile CASING JOINTS: Glued ... Clamped ...
 2 Brass 4 Galvanized steel 6 Asbestos-Cement 9 Other (specify below) Welded ...
 3 PVC 4 ABS 7 Fiberglass Threaded ...
 Blank casing diameter: 4 in. to 3 ft., Dia. ... in. to ... ft., Dia. ... in. to ... ft.
 Casing height above land surface: Flush in., weight: Sch 40 lbs./ft. Wall thickness or gauge No. ...
 TYPE OF SCREEN OR PERFORATION MATERIAL:
 1 Steel 3 Stainless steel 5 Fiberglass 8 RMP (SR) 10 Asbestos-cement
 2 Brass 4 Galvanized steel 6 Concrete tile 9 ABS 11 Other (specify) ...
 12 None used (open hole)
 SCREEN OR PERFORATION OPENINGS ARE:
 1 Continuous slot 3 Mill slot 5 Gauzed wrapped 8 Saw cut 11 None (open hole)
 2 Louvered shutter 4 Key punched 6 Wire wrapped 9 Drilled holes
 7 Torch cut 10 Other (specify) ...
 SCREEN-PERFORATED INTERVALS: From 13.5 ft. to 3 ft. From ... ft. to ... ft.
 GRAVEL PACK INTERVALS: From 13.5 ft. to 2 ft. From ... ft. to ... ft.

6 GROUT MATERIAL: 1 Neat cement 2 Cement grout 3 Bentonite 4 Other
 Grout Intervals: 3 From 2 ft. to 1 ft. From 1 ft. to 0 ft. From ... ft. to ... ft.
 What is the nearest source of possible contamination:
 1 Septic tank 4 Lateral lines 7 Pit privy 10 Livestock pens 14 Abandoned water well
 2 Sewer lines 5 Cess pool 8 Sewage lagoon 11 Fuel storage 15 Oil well/Gas well
 3 Watertight sewer lines 6 Seepage pit 9 Feedyard 12 Fertilizer storage 16 Other (specify below): Contaminated site
 13 Insecticide storage
 Direction from well? How many feet?

FROM	TO	LITHOLOGIC LOG	FROM	TO	PLUGGING INTERVALS
0	1.5	concrete			
.5	4	clay fill			
4	12	sand fill			
12	13.5	clay w/ some silt			
13.5	TD	end of bore hole			

7 CONTRACTOR'S OR LANDOWNER'S CERTIFICATION: This water well was (1) constructed, (2) reconstructed, or (3) plugged under my jurisdiction and was completed on (mo/day/year) 12/2/99 and this record is true to the best of my knowledge and belief. Kansas Water Well Contractor's License No. 505 This Water Well Record was completed on (mo/day/yr) 12/6/99 under the business name of AEL by (signature) A. Duran AIDW

OFFICE USE ONLY
 T
 R
 EW
 SEC.
 1/4
 1/4
 1/4