


1 LOCATION OF WATER WELL: County: Lyon Fraction NW 1/4 NW 1/4 NE 1/4 Section Number 15 Township Number T 19 S Range Number R 11 E/W

Distance and direction from nearest town or city street address of well if located within city? 4th & Commercial Site, Emporia, Kansas

2 WATER WELL OWNER: KDHE Bldg 740, Forbes Field Topeka, Kansas 66620 Board of Agriculture, Division of Water Resources Application Number:

3 LOCATE WELL'S LOCATION WITH AN "X" IN SECTION BOX: NW NE SW SE Depth of Completed Well 25 ft. Elevation 1141.04

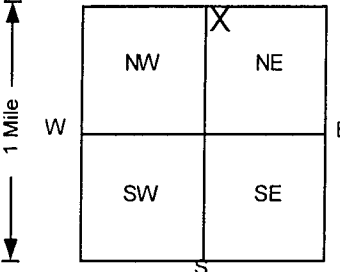

5 TYPE OF BLANK CASING USED: 2 PVC 3 RMP (SR) 4 ABS 5 Wrought iron 6 Asbestos-Cement 7 Fiberglass 8 Concrete tile 9 Other (specify below) CASING JOINTS: Glued Clamped Welded Threaded

6 GROUT MATERIAL: 2 Cement grout 3 Bentonite 4 Other Grout Intervals: From 0 ft to 4 ft, From 4 ft to 7 ft

LITHOLOGIC LOG table with columns FROM, TO, LITHOLOGIC LOG, FROM, TO, PLUGGING INTERVALS. Includes entries for Asphalt, Clay, and Gravel.

7 CONTRACTOR'S OR LANDOWNER'S CERTIFICATION: This water well was constructed, reconstructed, or plugged under my jurisdiction and was completed on 4/10/01 and this record is true to the best of my knowledge and belief.

INSTRUCTIONS: Use typewriter or ball point pen. PLEASE PRESS FIRMLY and PRINT clearly. Please fill in blanks, underline or circle the correct answers.