


1 LOCATION OF WATER WELL: Fraction Section Number Township Number Range Number
 County: **Lyon** SW ¼ NW ¼ NE ¼ 15 T 19 S R 11 **E/W**

Distance and direction from nearest town or city street address of well if located within city?
4th & Commercial site, Emporia, Kansas

2 WATER WELL OWNER: **KDHE**
 RR#, St. Address, Box # : **Bldg 740, Forbes Field**
 City, State, ZIP Code : **Topeka, Kansas 66620**
 Board of Agriculture, Division of Water Resources
 Application Number:

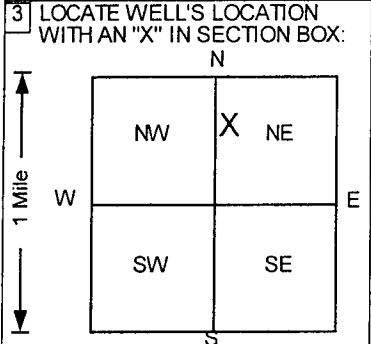

4 DEPTH OF COMPLETED WELL **28.5** ft. ELEVATION: **1138.6**
 Depth(s) Groundwater Encountered 1. ft. 2. ft. 3. ft.
 WELL'S STATIC WATER LEVEL ft. below land surface measured on mo/day/yr
 Pump test data: Well water was **NA** ft. after hours pumping gpm
 Est. Yield **NA** gpm: Well water was ft. after hours pumping gpm
 Bore Hole Diameter **8** in. to **28.5** ft., and in. to ft.
 WELL WATER TO BE USED AS: 5 Public water supply 8 Air conditioning 11 Injection well
 1 Domestic 3 Feedlot 6 Oil field water supply 9 Dewatering 12 Other (Specify below)
 2 Irrigation 4 Industrial 7 Lawn and garden only **10** Monitoring well
 Was a chemical/bacteriological sample submitted to Department? Yes.....No.....; If yes, mo/day/yr sample was submitted
 Water Well Disinfected? Yes No

5 TYPE OF BLANK CASING USED: 5 Wrought iron 8 Concrete tile CASING JOINTS: Glued Clamped
 1 Steel 3 RMP (SR) 6 Asbestos-Cement 9 Other (specify below) Welded
2 PVC 4 ABS 7 Fiberglass Threaded.
 Blank casing diameter 2 in. to 13 ft., Dia in. to ft., Dia in. to ft.
 Casing height above land surface -7.08 in., weight lbs./ft. Wall thickness or gauge No. **Sch. 40**
 TYPE OF SCREEN OR PERFORATION MATERIAL **7** PVC 10 Asbestos-cement
 1 Steel 3 Stainless steel 5 Fiberglass **8** RMP (SR) 11 Other (specify)
 2 Brass 4 Galvanized steel 6 Concrete tile 9 ABS 12 None used (open hole)
 SCREEN OR PERFORATION OPENINGS ARE: 5 Gauzed wrapped 8 Saw cut 11 None (open hole)
 1 Continuous slot **3** Mill slot 6 Wire wrapped 9 Drilled holes
 2 Louvered shutter 4 Key punched 7 Torch cut 10 Other (specify)
 SCREEN-PERFORATED INTERVALS: From 13 ft. to 28.5 ft., From ft. to ft.
 GRAVEL PACK INTERVALS: From 10 ft. to 28.5 ft., From ft. to ft.
 From ft. to ft., From ft. to ft.

6 GROUT MATERIAL: 1 Neat cement **2** Cement grout **3** Bentonite 4 Other
 Grout Intervals: From 0 ft. to 6.5 ft., From 6.5 ft. to 10 ft., From ft. to ft.
 What is the nearest source of possible contamination:
 1 Septic tank 4 Lateral lines 7 Pit privy 10 Livestock pens 14 Abandoned water well
 2 Sewer lines 5 Cess pool 8 Sewage lagoon 11 Fuel storage 15 Oil well/Gas well
 3 Watertight sewer lines 6 Seepage pit 9 Feedyard 12 Fertilizer storage 16 Other (specify below)
 Direction from well? How many feet? **0**

FROM	TO	LITHOLOGIC LOG	FROM	TO	PLUGGING INTERVALS
0	0.5	Asphalt,			
0.5	2	Clay, Moderate Yellow Brown to Dark Yellow			
2	7	Fill Material,			
7	9	Clay, Dusky Yellow Brown			
9	10.5	Clay, Dark Yellow brown			
10.5	14.5	Clay, Light Brown			
14.5	15.5	Sand, Light Brown			
15.5	16	Clay, Light Olive Gray			
16	16.75	Sand,			
16.75	17	Clay, Moderate Yellow Brown			
17	18.25	Sand,			
18.25	28.5	Gravel (Chert),			
					MW8 , Flushmount
					Project Name: BM - Emporia KDHE Site Inv
					GeoCore # 948 , #

7 CONTRACTOR'S OR LANDOWNER'S CERTIFICATION: This water well was **1** constructed, **2** reconstructed, or **3** plugged under my jurisdiction and was completed on (mo/day/year) **4/5/01** and this record is true to the best of my knowledge and belief.
 Kansas Water Well Contractor's License No. **527** This Water Well Record was completed on (mo/day/yr) **5/4/01**
 under the business name of **GeoCore Services, Inc.** by (signature) *[Signature]*