


1 LOCATION OF WATER WELL: County: Lyon Fraction: NE 1/4 SW 1/4 SE 1/4 Section Number: 3 Township Number: T 19 S Range Number: R 11 E/W

Distance and direction from nearest town or city street address of well if located within city? 1829 Merchant St.

2 WATER WELL OWNER: S+S Oil + Propane MWI Board of Agriculture, Division of Water Resources Application Number:

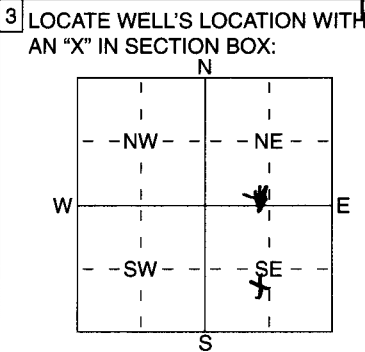

3 LOCATE WELL'S LOCATION WITH AN 'X' IN SECTION BOX: 4 DEPTH OF COMPLETED WELL: 17.5 ft. ELEVATION: ... WELL'S STATIC WATER LEVEL ...

5 TYPE OF BLANK CASING USED: 1 Steel, 3 RMP (SR), 4 ABS, 7 Fiberglass, 8 Concrete tile, 9 Other (specify below) CASING JOINTS: Glued, Clamped, Welded, Threaded ...

6 GROUT MATERIAL: 1 Neat cement, 2 Cement grout, 3 Bentonite, 4 Other: Cement 0-2' Grout Intervals: ... What is the nearest source of possible contamination: ...

Table with columns: FROM, TO, LITHOLOGIC LOG, FROM, TO, PLUGGING INTERVALS. Contains handwritten entries for concrete cover, silty clay, shale bedrock, etc.

7 CONTRACTOR'S OR LANDOWNER'S CERTIFICATION: This water well was (1) constructed, (2) reconstructed, or (3) plugged under my jurisdiction and was completed on (mo/day/year) 2/24/05 ...