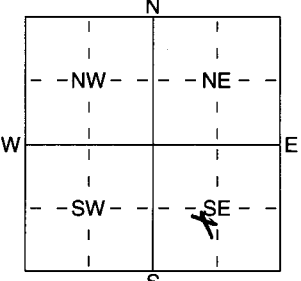


1 LOCATION OF WATER WELL: Fraction NE 1/4 SW 1/4 SE 1/4 Section Number 3 Township Number T 19 S Range Number R 11 EW
 County: LYON

Distance and direction from nearest town or city street address of well if located within city?
1029 Merchant Street

2 WATER WELL OWNER: S+S Oil + Propane MW3
 RR#, St. Address, Box #: 1029 Merchant Street
 City, State, ZIP Code: Emporia, Kansas 66801
 Board of Agriculture, Division of Water Resources
 Application Number:

3 LOCATE WELL'S LOCATION WITH AN "X" IN SECTION BOX:

 4 DEPTH OF COMPLETED WELL 20 ft. ELEVATION:
 Depth(s) Groundwater Encountered 1 ft. 2 ft. 3 ft.
 WELL'S STATIC WATER LEVEL ft. below land surface measured on mo/day/yr
 Pump test data: Well water was ft. after hours pumping gpm
 Est. Yield gpm: Well water was ft. after hours pumping gpm
 WELL WATER TO BE USED AS:
 5 Public water supply 8 Air conditioning 11 Injection well
 1 Domestic 3 Feedlot 6 Oil field water supply 9 Dewatering 12 Other (Specify below)
 2 Irrigation 4 Industrial 7 Domestic (lawn & garden) 10 Monitoring well
 Was a chemical/bacteriological sample submitted to Department? Yes No; If yes, mo/day/yr sample was submitted
 Water Well Disinfected? Yes No

5 TYPE OF BLANK CASING USED:
 1 Steel 3 RMP (SR) 5 Wrought iron 8 Concrete tile CASING JOINTS: Glued Clamped
 2 PVC 4 ABS 6 Asbestos-Cement 9 Other (specify below) Welded
 7 Fiberglass Threaded
 Blank casing diameter 2 in. to 5 ft., Dia in. to ft., Dia in. to ft.
 Casing height above land surface in., weight lbs./ft. Wall thickness or gauge No.
 TYPE OF SCREEN OR PERFORATION MATERIAL:
 1 Steel 3 Stainless Steel 5 Fiberglass 7 PVC 10 Asbestos-Cement
 2 Brass 4 Galvanized Steel 6 Concrete tile 8 RMP (SR) 11 Other (Specify)
 9 ABS 12 None used (open hole)
 SCREEN OR PERFORATION OPENINGS ARE:
 1 Continuous slot 3 Mill slot 5 Gauzed wrapped 8 Saw cut 11 None (open hole)
 2 Louvered shutter 4 Key punched 6 Wire wrapped 9 Drilled holes
 7 Torch cut 10 Other (specify) ft.
 SCREEN-PERFORATED INTERVALS: From 5 ft. to 20 ft., From ft. to ft.
 GRAVEL PACK INTERVALS: From 3.5 ft. to 20 ft., From ft. to ft.

6 GROUT MATERIAL: 1 Neat cement 2 Cement grout 3 Bentonite 4 Other Cement 0-1.5
 Grout Intervals: From ft. to ft., From ft. to ft., From ft. to ft.
 What is the nearest source of possible contamination:
 1 Septic tank 4 Lateral lines 7 Pit privy 11 Fuel storage 14 Abandoned water well
 2 Sewer lines 5 Cess pool 8 Sewage lagoon 12 Fertilizer storage 15 Oil well/Gas well
 3 Watertight sewer lines 6 Seepage pit 9 Feedyard 13 Insecticide storage 16 Other (specify below)
 Direction from well? How many feet?

| FROM | TO | LITHOLOGIC LOG | FROM | TO | PLUGGING INTERVALS |
|------|------|---|------|----|--------------------|
| 0 | 10.5 | Silty clay, brown to dark brown, high plasticity, trace petroleum odor. | | | |
| | 4' | olive green color, trace staining (iron oxide) | | | |
| 10.5 | 20' | hard shale bedrock, olive green, trace pet. odor | | | |
| | | | | | |
| | | | | | |
| | | | | | |
| | | | | | |
| | | | | | |
| | | | | | |
| | | | | | |

Flushmount
water by D. Taylor

7 CONTRACTOR'S OR LANDOWNER'S CERTIFICATION: This water well was (1) constructed, (2) reconstructed, or (3) plugged under my jurisdiction and was completed on (mo/day/year) 2/24/05 and this record is true to the best of my knowledge and belief. Kansas Water Well Contractor's Licence No 757 This Water Well Record was completed on (mo/day/yr) 3/21/05 under the business name of Larkin & Associates Inc by (signature) Kelly Mann