


1 LOCATION OF WATER WELL: Fraction SE 1/4 SE 1/4 SW 1/4 Section Number 2 Township Number T 19 S Range Number R 11 EW
 County: LYON

Distance and direction from nearest town or city street address of well if located within city?
1423 WHITTIER ST. EMPORIA KS 66801

2 WATER WELL OWNER: FROM: FRANK & CAROL BUFFINGTON RRS- BOX 42C- SAFFORDVILLE KS -
 RR#, St. Address, Box #: TO: ANGILO STOTTS Board of Agriculture, Division of Water Resources
 City, State, ZIP Code: 1423 WHITTIER ST. EMPORIA KS 66801 Application Number:

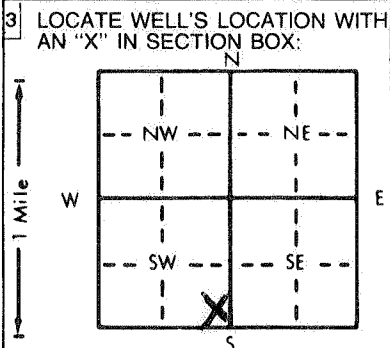

4 DEPTH OF COMPLETED WELL: 30 (?) ft. ELEVATION: _____
 Depth(s) Groundwater Encountered 1. UNKNOWN ft. 2. _____ ft. 3. _____ ft.
 WELL'S STATIC WATER LEVEL: 11.5 ft. below land surface measured on mo/day/yr 08-07-93
 Pump test data: Well water was IN SLUG ft. after _____ hours pumping _____ gpm
 Est. Yield 15 gpm; Well water was _____ ft. after _____ hours pumping _____ gpm
 Bore Hole Diameter: 90 in. to 30 ft., and _____ in. to _____ ft.
 WELL WATER TO BE USED AS:
 5 Public water supply 8 Air conditioning 11 Injection well
 1 Domestic 3 Feedlot 6 Oil field water supply 9 Dewatering 12 Other (Specify below)
 ② Irrigation 4 Industrial 7 Lawn and garden only 10 Monitoring well PLUGGED
 Was a chemical/bacteriological sample submitted to Department? Yes _____ No X; If yes, mo/day/yr sample was submitted _____
 Water Well Disinfected? Yes X No _____

5 TYPE OF BLANK CASING USED:
 1 Steel 3 RMP (SR) 5 Wrought iron 8 Concrete tile CASING JOINTS: Glued _____ Clamped _____
 2 PVC 4 ABS 6 Asbestos-Cement 9 Other (specify below) Welded _____
 7 Fiberglass LIME STONE - ROCKS Threaded _____
 Blank casing diameter 90 in. to TD ft., Dia _____ in. to _____ ft., Dia _____ in. to _____ ft.
 Casing height above land surface 16 in., weight 1300 PER C.F lbs./ft. Wall thickness or gauge No. 12" TO 18"
 TYPE OF SCREEN OR PERFORATION MATERIAL: NA
 1 Steel 3 Stainless steel 5 Fiberglass 7 PVC 10 Asbestos-cement
 2 Brass 4 Galvanized steel 6 Concrete tile 8 RMP (SR) 11 Other (specify) _____
 9 ABS 12 None used (open hole)
 SCREEN OR PERFORATION OPENINGS ARE:
 1 Continuous slot 3 Mill slot 5 Gauzed wrapped 8 Saw cut 11 None (open hole)
 2 Louvered shutter 4 Key punched 6 Wire wrapped 9 Drilled holes
 7 Torch cut 10 Other (specify) OPEN BETWEEN R&A
 SCREEN-PERFORATED INTERVALS: From NA ft. to _____ ft., From _____ ft. to _____ ft.
 GRAVEL PACK INTERVALS: From NA ft. to _____ ft., From _____ ft. to _____ ft.

6 GROUT MATERIAL: 1 Neat cement 2 Cement grout 3 Bentonite 4 Other _____
 Grout Intervals: From 4.5 ft. to 5 ft., From _____ ft. to _____ ft., From _____ ft. to _____ ft.
 What is the nearest source of possible contamination:
 1 Septic tank 4 Lateral lines 7 Pit privy 10 Livestock pens 14 Abandoned water well
 2 Sewer lines 5 Cess pool 8 Sewage lagoon 11 Fuel storage 15 Oil well/Gas well
 3 Watertight sewer lines 6 Seepage pit 9 Feedyard 12 Fertilizer storage 16 Other (specify below)
 13 Insecticide storage
 Direction from well? #11-15' SW BUTANE-UNDERGROUND #14-AND BY EL POLE 200' ? - AUGER WELL?

FROM	TO	LITHOLOGIC LOG	FROM	TO	PLUGGING INTERVALS
		<u>NO RECORDS</u>	<u>0</u>	<u>4.5</u>	<u>SOIL & CLAY</u>
		<u>HAND DUG</u>	<u>4.5</u>	<u>5</u>	<u>BENTONITE</u>
			<u>5</u>	<u>12</u>	<u>CLAY AND ROCKS</u>
			<u>12</u>	<u>30</u>	<u>SAND</u>

7 CONTRACTOR'S OR LANDOWNER'S CERTIFICATION: This water well was (1) constructed, (2) reconstructed, or (3) plugged under my jurisdiction and was completed on (mo/day/year) 08-07-93 and this record is true to the best of my knowledge and belief. Kansas Water Well Contractor's License No. 479 This Water Well Record was completed on (mo/day/yr) 08-08-93 under the business name of EDBERTS DRILLING by (signature) Gregory Edberts