#7

WATER WELL RECORD Form WWC-5 KSA 82a-1212

LOCATION OF WATER WELL: County: LYON	Fraction: NE ¼ SE ¼ SE ¼	Section Number: 3	Township Number: T 19 S	Range Number: R 11 E/W

Distance and direction from nearest town or city street address of well if located within city?
APROX 3/4 M N OF I35 AND 3/4 M EAST OF BURLINGAME RD

WATER WELL OWNER: E. L. HOPKINS
RR#, St. Address, Box # : 1576 BURLINGAME RD EMPORIA KS 66801
City, State, ZIP Code :
Board of Agriculture, Division of Water Resources Application Number: –

LOCATE WELL'S LOCATION WITH AN "X" IN SECTION BOX:

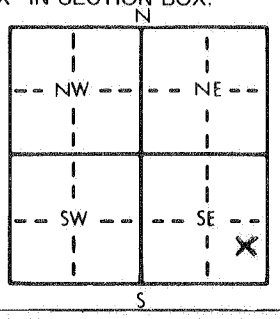

4 DEPTH OF COMPLETED WELL 22 ft. ELEVATION:
Depth(s) Groundwater Encountered 1. 8 ft. 2. 17 ft. 3. – ft.
WELL'S STATIC WATER LEVEL 6 ft. below land surface measured on mo/day/yr 10-18-90
Pump test data: Well water was 12 ft. after 1 hours pumping 51 gpm
Est. Yield 75 gpm: Well water was – ft. after – hours pumping – gpm
Bore Hole Diameter 36 in. to 96" 22 ft., and – in. to – ft.
WELL WATER TO BE USED AS: 5 Public water supply 8 Air conditioning 11 Injection well
1 Domestic 3 Feedlot 6 Oil field water supply 9 Dewatering 12 Other (Specify below)
2 Irrigation 4 Industrial 7 Lawn and garden only 10 Monitoring well –
Was a chemical/bacteriological sample submitted to Department? Yes ..... No X ; If yes, mo/day/yr sample was submitted
Water Well Disinfected? Yes X No

TYPE OF BLANK CASING USED: 5 Wrought iron 8 Concrete tile CASING JOINTS: Glued X Clamped –
1 Steel 3 RMP (SR) 6 Asbestos-Cement 9 Other (specify below) Welded –
2 PVC 4 ABS 7 Fiberglass – Threaded –
Blank casing diameter 6 in. to 22 ft., Dia – in. to – ft., Dia – in. to – ft.
Casing height above land surface 48 in., weight lbs./ft. Wall thickness or gauge No.
TYPE OF SCREEN OR PERFORATION MATERIAL: 7 PVC 10 Asbestos-cement
1 Steel 3 Stainless steel 5 Fiberglass 8 RMP (SR) 11 Other (specify) –
2 Brass 4 Galvanized steel 6 Concrete tile 9 ABS 12 None used (open hole)
SCREEN OR PERFORATION OPENINGS ARE: 5 Gauzed wrapped 8 Saw cut 11 None (open hole)
1 Continuous slot 3 Mill slot 6 Wire wrapped 9 Drilled holes
2 Louvered shutter 4 Key punched 7 Torch cut 10 Other (specify)
SCREEN-PERFORATED INTERVALS: From 17 ft. to 22 ft., From – ft. to – ft.
From – ft. to – ft., From – ft. to – ft.
GRAVEL PACK INTERVALS: From 10 ft. to 22 ft., From – ft. to – ft.
From – ft. to – ft., From – ft. to – ft.

GROUT MATERIAL: 1 Neat cement 2 Cement grout *3 Bentonite *4 Other CLAY
Grout Intervals: From X ft. to ft., From ft. to ft., From ft. to ft.
What is the nearest source of possible contamination: 10 Livestock pens 14 Abandoned water well
1 Septic tank 4 Lateral lines 7 Pit privy 11 Fuel storage 15 Oil well/Gas well
2 Sewer lines 5 Cess pool 8 Sewage lagoon 12 Fertilizer storage 16 Other (specify below)
3 Watertight sewer lines 6 Seepage pit 9 Feedyard 13 Insecticide storage LAKE - E - 160' mote - N - 90'
Direction from well? E How many feet? 15'

FROM	TO	LITHOLOGIC LOG	FROM	TO
0	1	TOP SOIL DK SILT		
1	17	CLAY SILT		
17	22	GRAVEL - LARGE + CLEAN		
			CLAY	
			SILT	
		8" - VEIN 1/3 GPM PLUGGED OUT		
		PER REF D. PLUMMER 10-16-90		

PLUGGING INTERVALS

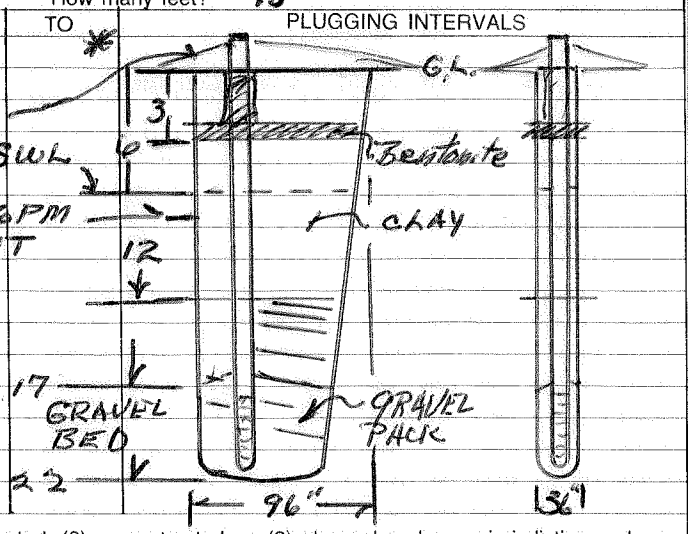

7 CONTRACTOR'S OR LANDOWNER'S CERTIFICATION: This water well was (1) constructed, (2) reconstructed, or (3) plugged under my jurisdiction and was completed on (mo/day/year) 10-17-90 and this record is true to the best of my knowledge and belief. Kansas Water Well Contractor's License No. 479 This Water Well Record was completed on (mo/day/yr) 10-19-90 under the business name of EBBERTS DRILLING by (signature) Hogan Ebbert

INSTRUCTIONS: Use typewriter or ball point pen. PLEASE PRESS FIRMLY and PRINT clearly. Please fill in blanks, underline or circle the correct answers. Send top three copies to Kansas Department of Health and Environment, Bureau of Water, Topeka, Kansas 66620-7320. Telephone: 913-296-5545. Send one to WATER WELL OWNER and retain one for your records.