


1] LOCATION OF WATER WELL: County: LYON Fraction: SW 1/4 SE 1/4 NW 1/4 Section Number: 7 Township Number: T 19 S Range Number: R 11 EW

Distance and direction from nearest town or city street address of well if located within city?
WEST HW 50 FROM EMPORIA 1ST HOUSE N-SIDE - WEST OF TURNPIKE UNDERPASS


2] WATER WELL OWNER: DEBAUGE BROS. INC
 RR#, St. Address, Box #: 2915 W 15 Board of Agriculture, Division of Water Resource
 City, State, ZIP Code: EMPORIA KS 66801 Application Number:

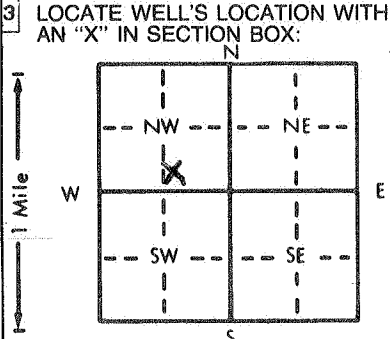

4] DEPTH OF COMPLETED WELL: UNKNOWN ft. ELEVATION: UNKNOWN
 Depth(s) Groundwater Encountered: 1 ft. 2. UNKNOWN ft. 3. UNKNOWN ft.
 WELL'S STATIC WATER LEVEL: 18 ft. below land surface measured on mo/day/yr 04-07-88
 Pump test data: Well water was UNKNOWN ft. after UNKNOWN hours pumping UNKNOWN gpm
 Est. Yield UNKNOWN gpm: Well water was UNKNOWN ft. after UNKNOWN hours pumping UNKNOWN gpm
 Bore Hole Diameter: UNKNOWN in. to UNKNOWN ft., and UNKNOWN in. to UNKNOWN ft.
 WELL WATER TO BE USED AS:
 5 Public water supply 8 Air conditioning 11 Injection well
 1 Domestic 3 Feedlot 6 Oil field water supply 9 Dewatering 12 Other (Specify below)
 2 Irrigation 4 Industrial 7 Lawn and garden only 10 Monitoring well no idea
 Was a chemical/bacteriological sample submitted to Department? Yes NO No X; If yes, mo/day/yr sample was submitted UNKNOWN
 Water Well Disinfected? Yes X No NO

5] TYPE OF BLANK CASING USED:
 1 Steel 3 RMP (SR) 5 Wrought iron 8 Concrete tile CASING JOINTS: Glued NO Clamped NO
 2 PVC 4 ABS 6 Asbestos-Cement 9 Other (specify below) Welded NO
 7 Fiberglass CLAY TILE Threaded NO
 Blank casing diameter: 6 in. to UNKNOWN ft., Dia. UNKNOWN in. to UNKNOWN ft., Dia. UNKNOWN in. to UNKNOWN ft.
 Casing height above land surface: APPROX 36 in., weight Below lbs./ft. Wall thickness or gauge No. UNKNOWN
 TYPE OF SCREEN OR PERFORATION MATERIAL:
 1 Steel 3 Stainless steel 5 Fiberglass 7 PVC 10 Asbestos-cement
 2 Brass 4 Galvanized steel 6 Concrete tile 8 RMP (SR) 11 Other (specify) NO
 9 ABS 12 None used (open hole)
 SCREEN OR PERFORATION OPENINGS ARE:
 1 Continuous slot 3 Mill slot 5 Gauzed wrapped 8 Saw cut 11 None (open hole)
 2 Louvered shutter 4 Key punched 6 Wire wrapped 9 Drilled holes
 7 Torch cut 10 Other (specify) NO
 SCREEN-PERFORATED INTERVALS: From UNKNOWN ft. to UNKNOWN ft., From UNKNOWN ft. to UNKNOWN ft.
 GRAVEL PACK INTERVALS: From UNKNOWN ft. to UNKNOWN ft., From UNKNOWN ft. to UNKNOWN ft.

6] GROUT MATERIAL: 1 Neat cement 2 Cement grout 3 Bentonite 4 Other NO
 Grout Intervals: From 3 ft. to 24 ft., From UNKNOWN ft. to UNKNOWN ft., From UNKNOWN ft. to UNKNOWN ft.
 What is the nearest source of possible contamination:
 1 Septic tank ? 4 Lateral lines 7 Pit privy 10 Livestock pens 14 Abandoned water well
 2 Sewer lines 5 Cess pool 8 Sewage lagoon 11 Fuel storage 15 Oil well/Gas well
 3 Watertight sewer lines 6 Seepage pit 9 Feedyard 12 Fertilizer storage 16 Other (specify below)
 13 Insecticide storage
 Direction from well? S AND W How many feet? 11' - 30'

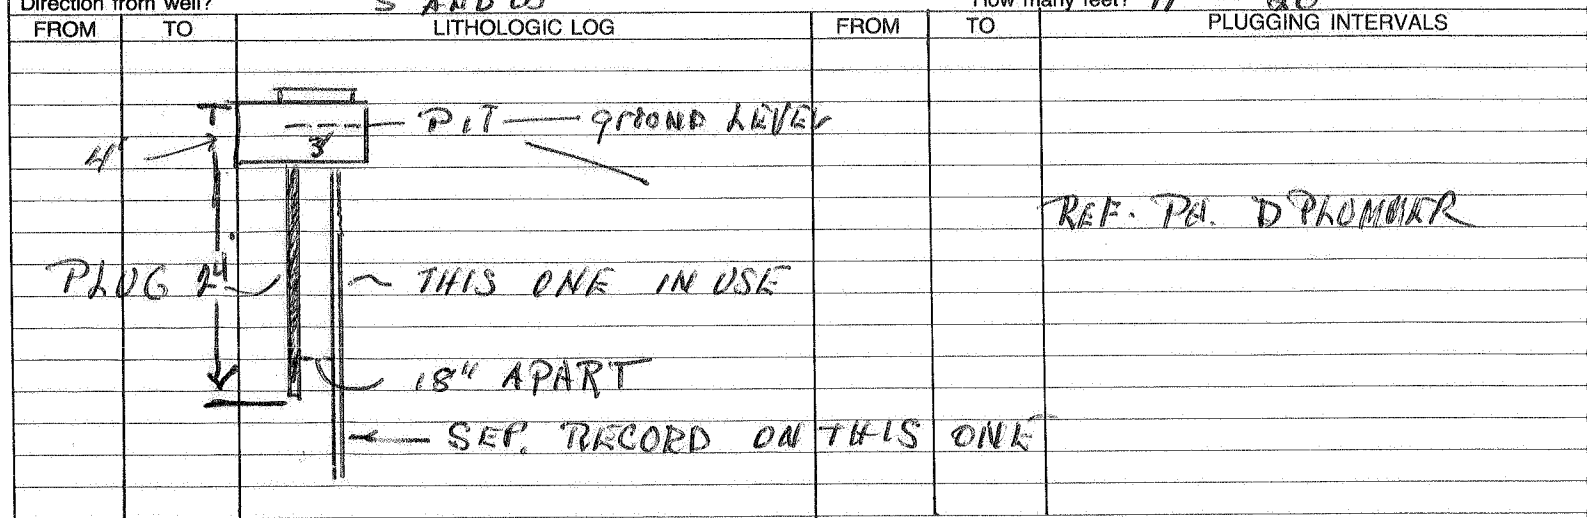

7] CONTRACTOR'S OR LANDOWNER'S CERTIFICATION: This water well was (1) constructed, (2) reconstructed, or (3) plugged under my jurisdiction and was completed on (mo/day/year) 04-12-88 and this record is true to the best of my knowledge and belief. Kansas Water Well Contractor's License No. 479 This Water Well Record was completed on (mo/day/yr) 05-14-88 under the business name of EBBERTS DRILLING by (signature) Angela Ebbert