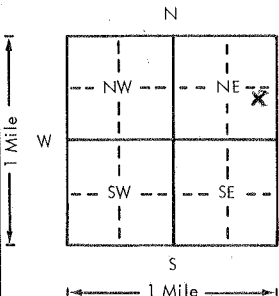
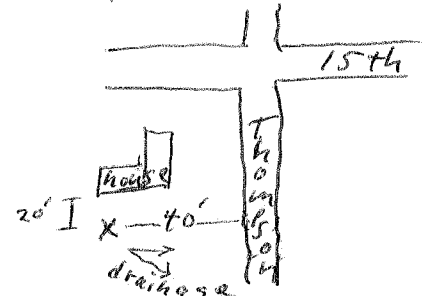


USE TYPEWRITER OR BALL POINT PEN-PRESS FIRMLY, PRINT CLEARLY.

WATER WELL RECORD
KSA 82a-1201-1215

Kansas Department of Health and Environment-Division of Environment (Water well Contractors) Topeka, Kansas 66620

1. Location of well: LYON		County: LYON	Fraction: NE 1/4 SW 1/4 NE 1/4	Section number: 8	Township number: T 19 S R 11 E W	Range number: 11	
2. Distance and direction from nearest town or city: Street address of well location if in city: 1277 Thompson				3. Owner of well: Robert W. Mossman R.R. or street: 1277 Thompson City, state, zip code: Emporia, KS. 66801			
4. Locate with "X" in section below: 				Sketch map: 			
5. Type and color of material				From	To		
Dirt + gravel				0	10		
Gravel + shale				10	12		
Shale				12	17		
Rock (tan, hard)				17	18		
Clay (tan)				18	28		
Rock (dark tan, hard)				28	30		
Sandy clay (tan)				30	33		
Shale (gray)				33	38		
Sandstone (gray)				38	40		
Shale (gray)				40	44		
Sandstone (gray, hard)				44	46		
Shale (gray)				46	48		
Sandstone or limestone (gray)				48	50		
Shale with some grit (gray)				50	98		
Sandstone or limestone (gray)				98	99		
Shale (gray)				99	111		
Sandstone (light gray) very hard				111	113		
(Use a second sheet if needed)							
18. Elevation:		19. Remarks: Insufficient source of water to merit casing. Plugged with natural material 11/4/78.				20. Water well contractor's certification: This well was drilled under my jurisdiction and this report is true to the best of my knowledge and belief. 372 Lespaguard W.W. Contrs. Business name: Lespaguard W.W. Contrs. License No.: 1312 Address: 1312 Trail Ridge Rd, Emporia, KS Signed: Berge J. Lespaguard Date: 11/6/78 Authorized representative	

Forward the white, blue and pink copies to the Department of Health and Environment

Form WWC-5