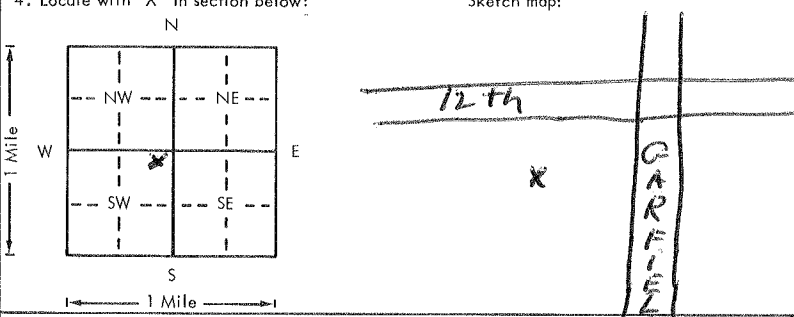


USE TYPEWRITER OR BALL POINT PEN-PRESS FIRMLY, PRINT CLEARLY.

WATER WELL RECORD
KSA 82a-1201-1215

Kansas Department of Health and Environment-Division of Environment (Water well Contractors) Topeka, Kansas 66620

1. Location of well:	County: Lyon	Fraction: NE 1/4 NE 1/4 SW 1/4	Section number: 9	Township number: T 19 S R 11 E	Range number: 11																																	
2. Distance and direction from nearest town or city: Street address of well location if in city: 1045 Garfield Emporia, Ks.		3. Owner of well: Vernon Feltner R.R. or street: 1045 Garfield City, state, zip code: Emporia, Ks. 66801																																				
4. Locate with "X" in section below: Sketch map: 			6. Bore hole dia. 6 in. Completion date: 9-27-80 Well depth 77 ft.																																			
5. Type and color of material			7. <input checked="" type="checkbox"/> Cable tool <input type="checkbox"/> Rotary <input type="checkbox"/> Driven <input type="checkbox"/> Dug <input type="checkbox"/> Hollow rod <input type="checkbox"/> Jetted <input type="checkbox"/> Bored <input type="checkbox"/> Reverse rotary																																			
<table border="1" style="width:100%; border-collapse: collapse;"> <thead> <tr> <th style="width:80%;">Type and color of material</th> <th style="width:10%;">From</th> <th style="width:10%;">To</th> </tr> </thead> <tbody> <tr><td>Top soil</td><td>0</td><td>2</td></tr> <tr><td>Tan clay</td><td>2</td><td>9</td></tr> <tr><td>Limestone (tan)</td><td>9</td><td>13</td></tr> <tr><td>Tan clay</td><td>13</td><td>18</td></tr> <tr><td>Limestone (tan)</td><td>18</td><td>19</td></tr> <tr><td>Tan clay</td><td>19</td><td>24</td></tr> <tr><td>Limestone (tan)</td><td>24</td><td>31</td></tr> <tr><td>Tan clay</td><td>31</td><td>42</td></tr> <tr><td>Gray shale</td><td>42</td><td>77</td></tr> <tr><td colspan="3" style="text-align:center;">(Use a second sheet if needed)</td></tr> </tbody> </table>			Type and color of material	From	To	Top soil	0	2	Tan clay	2	9	Limestone (tan)	9	13	Tan clay	13	18	Limestone (tan)	18	19	Tan clay	19	24	Limestone (tan)	24	31	Tan clay	31	42	Gray shale	42	77	(Use a second sheet if needed)			8. Use: <input type="checkbox"/> Domestic <input type="checkbox"/> Public supply <input type="checkbox"/> Industry <input type="checkbox"/> Irrigation <input type="checkbox"/> Air conditioning <input type="checkbox"/> Stock <input checked="" type="checkbox"/> Lawn <input type="checkbox"/> Oil field water <input type="checkbox"/> Other		
9. Casing: Material _____ Height: Above or below _____ Threaded _____ Welded _____ Surface _____ in. RMP _____ PVC _____ Weight _____ lbs./ft. Dia. _____ in. to _____ ft. depth Wall Thickness: inches or _____ Dia. _____ in. to _____ ft. depth gage No. _____			10. Screen: Manufacturer's name _____ Type _____ Dia. _____ Slot/gauze _____ Length _____ Set between _____ ft. and _____ ft. _____ ft. and _____ ft. Gravel pack? _____ Size range of material _____																																			
11. Static water level: _____ mo./day/yr. _____ ft. below land surface Date _____			12. Pumping level below land surfaces: _____ ft. after _____ hrs. pumping _____ g.p.m. _____ ft. after _____ hrs. pumping _____ g.p.m. Estimated maximum yield _____ g.p.m.																																			
13. Water sample submitted: _____ mo./day/yr. Yes _____ No _____ Date _____			14. Well head completion: <input type="checkbox"/> Pitless adapter _____ Inches above grade																																			
15. Well grouted? _____ With: _____ Neat cement _____ Bentonite _____ Concrete _____ Depth: From _____ ft. to _____ ft.			16. Nearest source of possible contamination: ft. _____ Direction _____ Type _____ Well disinfected upon completion? _____ Yes _____ No																																			
17. Pump: _____ Not installed Manufacturer's name _____ Model number _____ HP _____ Volts _____ Length of drop pipe _____ ft. capacity _____ g.p.m. Type: <input type="checkbox"/> Submersible <input type="checkbox"/> Turbine <input type="checkbox"/> Jet <input type="checkbox"/> Reciprocating <input type="checkbox"/> Centrifugal <input type="checkbox"/> Other			18. Elevation: _____																																			
19. Remarks: Insufficient amount of water encountered between 31 and 42 feet. Well was plugged.			20. Water well contractor's certification: This well was drilled under my jurisdiction and this report is true to the best of my knowledge and belief. Lespagnard W.W. Contrs. Business name _____ License No. _____ Address 1312 Trail Ridge Rd. Signed J. Lespagnard Date 9-30-80 Authorized representative																																			

Forward the white, blue and pink copies to the Department of Health and Environment

Form WWC-5

T 19 S R 11 E
1/4 NE 1/4 SW 1/4