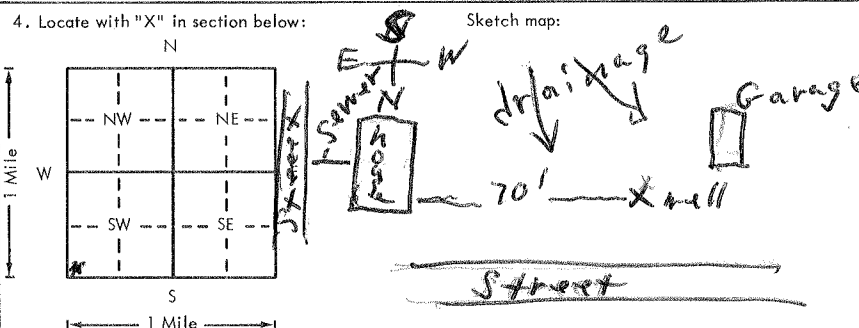


USE TYPEWRITER OR BALL POINT PEN-PRESS FIRMLY, PRINT CLEARLY.

WATER WELL RECORD
KSA 82a-1201-1215

Kansas Department of Health and Environment-Division of Environment (Water well Contractors) Topeka, Kansas 66620

1. Location of well:		County Lyon	Fraction SW 1/4 SW 1/4 SW 1/4	Section number 9	Township number T 19 S R 11 (E)W	Range number
2. Distance and direction from nearest town or city: Street address of well location if in city: 637 Woodland				3. Owner of well: Glen Soderstrom R.R. or street: 637 Woodland City, state, zip code: Emporia, Ks. 66801		
4. Locate with "X" in section below: 				6. Bore hole dia. 16 in. Completion date 11/18/78 Well depth 40 ft.		
5. Type and color of material				7. <input checked="" type="checkbox"/> Cable tool <input type="checkbox"/> Rotary <input type="checkbox"/> Driven <input type="checkbox"/> Dug <input type="checkbox"/> Hollow rod <input type="checkbox"/> Jetted <input type="checkbox"/> Bored <input type="checkbox"/> Reverse rotary		
Brown clay				8. Use: <input type="checkbox"/> Domestic <input type="checkbox"/> Public supply <input type="checkbox"/> Industry <input type="checkbox"/> Irrigation <input type="checkbox"/> Air conditioning <input type="checkbox"/> Stock <input checked="" type="checkbox"/> Lawn <input type="checkbox"/> Oil field water <input type="checkbox"/> Other		
Sandy silt (brown)				9. Casing: Material <input type="checkbox"/> Threaded <input type="checkbox"/> Welded <input checked="" type="checkbox"/> RMP <input checked="" type="checkbox"/> PVC Height: Above or below Surface 16 in. Weight 1.5 lbs./ft.		
Gravel with sand				Dia. 5 in. to 90 ft. depth Wall Thickness: inches or Dia. <input type="checkbox"/> in. to <input type="checkbox"/> ft. depth gage No. 200		
				10. Screen: Manufacturer's name Sunflower Sub Set Well Casing Type RMP Dia. 5 Slot/gauze .06 Length 8' Set between 32 ft. and 40 ft. Gravel pack? yes Size range of material 1/4-1/2 in		
				11. Static water level: 21 ft. below land surface Date 11/20/78 mo./day/yr.		
				12. Pumping level below land surfaces: ____ ft. after ____ hrs. pumping ____ g.p.m. ____ ft. after ____ hrs. pumping ____ g.p.m. Estimated maximum yield 30 g.p.m.		
				13. Water sample submitted: ____ Yes <input checked="" type="checkbox"/> No Date ____		
				14. Well head completion: 16 Inches above grade <input type="checkbox"/> Pitless adapter		
				15. Well grouted? yes With: <input type="checkbox"/> Neat cement <input type="checkbox"/> Bentonite <input checked="" type="checkbox"/> Concrete Depth: From 0 ft. to 10 ft.		
				16. Nearest source of possible contamination: ft. 80' Direction East Type sewer Well disinfected upon completion? ____ Yes <input checked="" type="checkbox"/> No		
				17. Pump: <input checked="" type="checkbox"/> Not installed Manufacturer's name _____ Model number _____ HP _____ Volts _____ Length of drop pipe _____ ft. capacity _____ g.p.m. Type: <input type="checkbox"/> Submersible <input type="checkbox"/> Turbine <input type="checkbox"/> Jet <input type="checkbox"/> Reciprocating <input type="checkbox"/> Centrifugal <input type="checkbox"/> Other		
(Use a second sheet if needed)						
18. Elevation:		19. Remarks: Concrete slab + well house to be installed by another. Submersible pump to be installed.			20. Water well contractor's certification: This well was drilled under my jurisdiction and this report is true to the best of my knowledge and belief. Lespagnard W.W. Contrs. 372 Business name _____ License No. _____ Address 312 Treil Ridge Rd. Signed George J. Lespagnard Date 12/15/78 Authorized representative	
Topography: <input type="checkbox"/> Hill <input type="checkbox"/> Slope <input type="checkbox"/> Upland <input checked="" type="checkbox"/> Valley						

Forward the white, blue and pink copies to the Department of Health and Environment

Form WWC-5