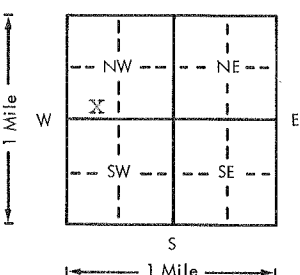


USE TYPEWRITER OR BALL POINT PEN-PRESS FIRMLY, PRINT CLEARLY.

WATER WELL RECORD  
KSA 82a-1201-1215

Kansas Department of Health and Environment-Division of Environment (Water well Contractors) Topeka, Kansas 66620

1. Location of well:	County <b>Lyon</b>	Fraction <b>SE 1/4 SW 1/4 NW 1/4</b>	Section number <b>11</b>	Township number <b>T 19 S R</b>	Range number <b>11</b> <span style="border: 1px solid black; border-radius: 50%; padding: 2px;">E/W</span>	
2. Distance and direction from nearest town or city: Street address of well location if in city: <b>716 East 12th. Emporia Kansas</b>			3. Owner of well: <b>Gene Stevenson</b> R.R. or street: <b>1407 Rural</b> City, state, zip code: <b>Emporia, Kansas 66801</b>			
4. Locate with "X" in section below: N  W E S 1 Mile			Sketch map:			
5. Type and color of material			From	To		
			top soil	black	0	6
			clay	yellow	6	20
			limestone	yellow	20	23
			shale	grey	23	27
			rock hard	light grey	27	32
			shale	grey	32	48
			rock hard	light grey	48	51
			shale	grey	51	74
			rock hard	light grey	74	78
shale	grey	78	81			
shale	red	<del>78</del> 81	85			
rock	light grey	85	88			
shale	grey	88	92			
limey shale	grey	92	95			
shale	grey/red	95	124			
shale	grey	124	150			
(Use a second sheet if needed)						
18. Elevation:		19. Remarks: <b>This was a dry hole and was plugged according to State laws.</b>				
Topography: <input type="checkbox"/> Hill <input type="checkbox"/> Slope <input checked="" type="checkbox"/> Upland <input type="checkbox"/> Valley		20. Water well contractor's certification: This well was drilled under my jurisdiction and this report is true to the best of my knowledge and belief. <b>Bledsoe Drilling Co. 349</b> Business name License No. <b>212 Maple Cottonwood Falls</b> Address Signed <b>John A. Bledsoe</b> Date <b>7-9-77</b> Authorized representative				

Forward the white, blue and pink copies to the Department of Health and Environment

Form WWC-5

L 9 L 11 W L L SE SW NW 1/4 1/4 1/4