WATER WELL RECORD Form WWC-5 KSA 82a-1212

1 LOCATION OF WATER WELL: County: LYON | Fraction: ~~NE~~ N ¼ ~~SE~~ N ¼ ~~SE~~ ¼ | Section Number: 11 | Township Number: T 19 S | Range Number: R 11 (E) W

Distance and direction from nearest town or city street address of well if located within city?
APROX FROM EMPORIA KS 7½ M N OF I 35 AND 3/8 M E OF BURLINGAME RD

2 WATER WELL OWNER: E.L. HOPKINS ID. WELL #2
RR#, St. Address, Box #: 1576 BURLINGAME RD
City, State, ZIP Code: EMPORIA KS 66801
Board of Agriculture, Division of Water Resources Application Number:

3 LOCATE WELL'S LOCATION WITH AN "X" IN SECTION BOX:

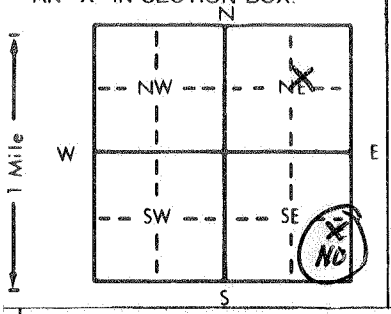

4 DEPTH OF COMPLETED WELL: 19'-9" BL ft. ELEVATION:
Depth(s) Groundwater Encountered 1. UNKNOWN ft. 2. ft. 3. ft.
WELL'S STATIC WATER LEVEL -4 ft. below land surface measured on mo/day/yr 06-02-90
Pump test data: Well water was ft. after hours pumping gpm
Est. Yield 30 gpm: Well water was ft. after hours pumping gpm
Bore Hole Diameter HOGH in. 48" X 20' AT TOP and TAPER - BACKHOE in. to ft.
WELL WATER TO BE USED AS: 1 Domestic 3 Feedlot 5 Public water supply 6 Oil field water supply 7 Lawn and garden only 8 Air conditioning 9 Dewatering 10 Monitoring well 11 Injection well 12 Other (Specify below) 2 Irrigation 4 Industrial
Was a chemical/bacteriological sample submitted to Department? Yes ..... No X ; If yes, mo/day/yr sample was submitted
Water Well Disinfected? Yes X No

5 TYPE OF BLANK CASING USED: 1 Steel 2 PVC 3 RMP (SR) 4 ABS 5 Wrought iron 6 Asbestos-Cement 7 Fiberglass 8 Concrete tile 9 Other (specify below)
CASING JOINTS: Glued X Clamped Welded Threaded
Blank casing diameter 6 in. to ft., Dia in. to ft., Dia in. to ft.
Casing height above land surface in., weight lbs./ft. Wall thickness or gauge No.
TYPE OF SCREEN OR PERFORATION MATERIAL: 1 Steel 2 Brass 3 Stainless steel 4 Galvanized steel 5 Fiberglass 6 Concrete tile 7 PVC 8 RMP (SR) 9 ABS 10 Asbestos-cement 11 Other (specify) 12 None used (open hole)
SCREEN OR PERFORATION OPENINGS ARE: 1 Continuous slot 2 Louvered shutter 3 Mill slot .035 4 Key punched 5 Gauzed wrapped 6 Wire wrapped 7 Torch cut 8 Saw cut 9 Drilled holes .625 10 Other (specify) 11 None (open hole)
SCREEN-PERFORATED INTERVALS: From 1¾' on Bottom to With SEVERAL From 62.5" D. HOLES DRILLED IN BOTTOM ft.
From ft. to ft., From ft. to ft.
GRAVEL PACK INTERVALS: From UNKNOWN ft. to ft., From ft. to ft.
From ft. to ft., From ft. to ft.

6 GROUT MATERIAL: 1 Neat cement 2 Cement grout 3 Bentonite 4 Other CLAY
Grout Intervals: From ft. to ft., From ft. to ft., From ft. to ft.
What is the nearest source of possible contamination: 1 Septic tank 2 Sewer lines 3 Watertight sewer lines 4 Lateral lines 5 Cess pool 6 Seepage pit 7 Pit privy 8 Sewage lagoon 9 Feedyard 10 Livestock pens 11 Fuel storage 12 Fertilizer storage 13 Insecticide storage 14 Abandoned water well 15 Oil well/Gas well 16 Other (specify below)
Direction from well? How many feet?

FROM	TO	LITHOLOGIC LOG	FROM	TO	PLUGGING INTERVALS
NO RECORDS					REF D.P BY PHONE
DUG + CONSTRUCTED BY OTHERS-			1990		KDHE
		REMOVED AND BACK FILLED WITH CLAY			
		CASEING LEANS TO NORTH			

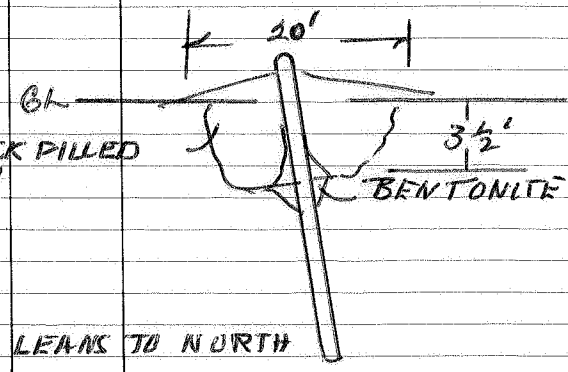

7 CONTRACTOR'S OR LANDOWNER'S CERTIFICATION: This water well was (1) constructed, (2) reconstructed, or (3) plugged under my jurisdiction and was completed on (mo/day/year) 06-05-90 and this record is true to the best of my knowledge and belief. Kansas Water Well Contractor's License No. 479 This Water Well Record was completed on (mo/day/yr) 06-09-90 under the business name of EBERTS DRILLING by (signature) [signature]

INSTRUCTIONS: Use typewriter or ball point pen. *PLEASE PRESS FIRMLY* and *PRINT* clearly. Please fill in blanks, underline or circle the correct answers. Send top three copies to Kansas Department of Health and Environment, Bureau of Water, Topeka, Kansas 66620-7320. Telephone: 913-296-5545. Send one to WATER WELL OWNER and retain one for your records.