


1 LOCATION OF WATER WELL: County: Lyon Fraction: SW $\frac{1}{4}$ SE $\frac{1}{4}$ NW $\frac{1}{4}$ Section Number: 11 Township Number: T 19 S Range Number: R 11 **EW**

Distance and direction from nearest town or city street address of well if located within city?

IN TOWN

2 WATER WELL OWNER: C-Halt
 RR#, St. Address, Box #: 1120 E. 12th
 City, State, ZIP Code: Emporia Ks
 Board of Agriculture, Division of Water Resources
 Application Number:

3 LOCATE WELL'S LOCATION WITH AN "X" IN SECTION BOX:

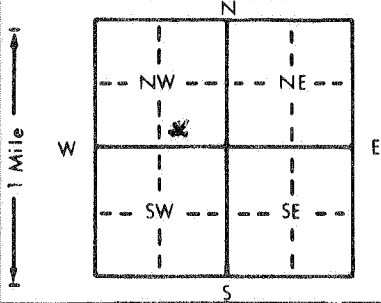

4 DEPTH OF COMPLETED WELL: 15 ft. ELEVATION:

Depth(s) Groundwater Encountered 1. 10 1/2 ft. 2. ft. 3. ft.

WELL'S STATIC WATER LEVEL: 10.45 ft. below land surface measured on mo/day/yr April 30th.

Pump test data: Well water was ft. after hours pumping gpm

Est. Yield gpm: Well water was ft. after hours pumping gpm

Bore Hole Diameter: 6 5/8 in. to 15 ft., and in. to ft.

WELL WATER TO BE USED AS: 5 Public water supply 8 Air conditioning 11 Injection well

1 Domestic 3 Feedlot 6 Oil field water supply 9 Dewatering 12 Other (Specify below)

2 Irrigation 4 Industrial 7 Lawn and garden only **10** Monitoring well

Was a chemical/bacteriological sample submitted to Department? Yes.....No **X**.....; If yes, mo/day/yr sample was submitted

Water Well Disinfected? Yes **No**

5 TYPE OF BLANK CASING USED: 5 Wrought iron 8 Concrete tile CASING JOINTS: Glued.....Clamped.....

1 Steel 3 RMP (SR) 6 Asbestos-Cement 9 Other (specify below) Welded.....

2 PVC 4 ABS 7 Fiberglass Threaded **X**

Blank casing diameter 2.42 in. to 5 ft., Dia. in. to ft., Dia. in. to ft.

Casing height above land surface Flush Mount in., weight lbs./ft. Wall thickness or gauge No. SDR-13

TYPE OF SCREEN OR PERFORATION MATERIAL: **7** PVC 10 Asbestos-cement sch 40

1 Steel 3 Stainless steel 5 Fiberglass 8 RMP (SR) 11 Other (specify)

2 Brass 4 Galvanized steel 6 Concrete tile 9 ABS 12 None used (open hole)

SCREEN OR PERFORATION OPENINGS ARE: 5 Gauzed wrapped 8 Saw cut 11 None (open hole)

1 Continuous slot **3** Mill slot 6 Wire wrapped 9 Drilled holes

2 Louvered shutter 4 Key punched 7 Torch cut 10 Other (specify)

SCREEN-PERFORATED INTERVALS: From 15 ft. to 5 ft., From ft. to ft.

GRAVEL PACK INTERVALS: From 15 ft. to 5 ft., From ft. to ft.

6 GROUT MATERIAL: **1** Neat cement 2 Cement grout **3** Bentonite 4 Other

Grout Intervals: From 5 ft. to 1 ft., From 1 ft. to 0 ft., From ft. to ft.

What is the nearest source of possible contamination: **3** **11**

1 Septic tank 4 Lateral lines 7 Pit privy **11** Fuel storage 14 Abandoned water well

2 Sewer lines 5 Cess pool 8 Sewage lagoon 12 Fertilizer storage 15 Oil well/Gas well

3 Watertight sewer lines 6 Seepage pit 9 Feedyard 13 Insecticide storage 16 Other (specify below)

Direction from well? North East How many feet? 75 ft

FROM	TO	LITHOLOGIC LOG	FROM	TO	PLUGGING INTERVALS
0	1 1/2	Clay - Brown organic rich soil			
1 1/2	3 1/2	Red Brown silty clay			
3 1/2	5	" " w/ chert gravel			
5	8 1/2	Red Brown cherty sandy clay			
8 1/2	10 1/2	Gray - Greenish gray sandy cherty clay			
10 1/2	14	cherty gravelly clay			
14	15	yellow Gray shale			

7 CONTRACTOR'S OR LANDOWNER'S CERTIFICATION: This water well was **1** constructed, (2) reconstructed, or (3) plugged under my jurisdiction and was completed on (mo/day/year) April 30th and this record is true to the best of my knowledge and belief. Kansas Water Well Contractor's License No. 539 This Water Well Record was completed on (mo/day/yr) May 9, 1992 under the business name of JB Environmental Drilling by signature James Biebel

INSTRUCTIONS: Use typewriter or ball point pen. PLEASE PRESS FIRMLY and PRINT clearly. Please fill in blanks, underline or circle the correct answers. Send top three copies to Kansas Department of Health and Environment, Bureau of Water, Topeka, Kansas 66620-7320. Telephone: 913-296-5545. Send one to WATER WELL OWNER and retain one for your records.