WATER WELL RECORD Form WWC-5 KSA 82a-1212

1 LOCATION OF WATER WELL: County: LYON | Fraction: SE ¼ SW ¼ SW ¼ | Section Number: 12 | Township Number: T 19 S | Range Number: R 11 (E/W)

Distance and direction from nearest town or city street address of well if located within city? 1/2 M. E OF INTERSECTION OF WEAVER + 6TH ST. - N OF 6TH - EMPORIA KS

2 WATER WELL OWNER: JERRY BEDNER

RR#, St. Address, Box # : 2302 E 6TH

City, State, ZIP Code : EMPORIA KS 66801

Board of Agriculture, Division of Water Resource

Application Number:

3 LOCATE WELL'S LOCATION WITH AN "X" IN SECTION BOX:

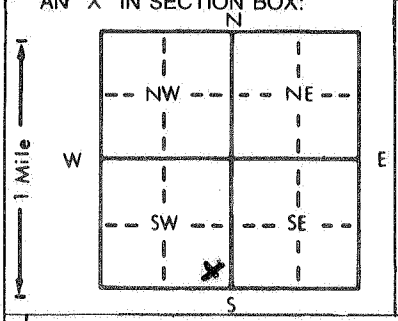

4 DEPTH OF COMPLETED WELL 50 P ft. ELEVATION: —

Depth(s) Groundwater Encountered 1. ? ft. 2. — ft. 3. — ft.

WELL'S STATIC WATER LEVEL 5 ft. below land surface measured on mo/day/yr 07-16-88

Pump test data: Well water was — ft. after — hours pumping — gpm

Est. Yield — gpm: Well water was — ft. after — hours pumping — gpm

Bore Hole Diameter 6 in. to TD ft., and — in. to — ft.

WELL WATER TO BE USED AS: 1 Domestic 2 Irrigation 3 Feedlot 4 Industrial 5 Public water supply 6 Oil field water supply 7 Lawn and garden only 8 Air conditioning 9 Dewatering 10 Monitoring well 11 Injection well 12 Other (Specify below) PLUGGED

Was a chemical/bacteriological sample submitted to Department? Yes ..... No X ; If yes, mo/day/yr sample was submitted —

Water Well Disinfected? Yes X No

5 TYPE OF BLANK CASING USED: 1 Steel 2 PVC 3 RMP (SR) 4 ABS 5 Wrought iron 6 Asbestos-Cement 7 Fiberglass 8 Concrete tile 9 Other (specify below) GALV. STEEL

CASING JOINTS: Glued — Clamped — Welded — Threaded —

Blank casing diameter 5 in. to TD ft., Dia — in. to — ft., Dia — in. to — ft.

Casing height above land surface 60 in., weight — lbs./ft. Wall thickness or gauge No. —

TYPE OF SCREEN OR PERFORATION MATERIAL: NA

1 Steel 2 Brass 3 Stainless steel 4 Galvanized steel 5 Fiberglass 6 Concrete tile 7 PVC 8 RMP (SR) 9 ABS 10 Asbestos-cement 11 Other (specify) — 12 None used (open hole)

SCREEN OR PERFORATION OPENINGS ARE: NA

1 Continuous slot 2 Louvered shutter 3 Mill slot 4 Key punched 5 Gauzed wrapped 6 Wire wrapped 7 Torch cut 8 Saw cut 9 Drilled holes 10 Other (specify) — 11 None (open hole)

SCREEN-PERFORATED INTERVALS: From — ft. to — ft., From — ft. to — ft.

From ft. to ft., From ft. to ft.

GRAVEL PACK INTERVALS: From TD ft. to 25 ft., From — ft. to — ft.

From — ft. to — ft., From — ft. to — ft.

6 GROUT MATERIAL: 1 Neat cement 2 Cement grout 3 Bentonite 4 Other —

Grout Intervals: From 25 ft. to 5 ft., From — ft. to — ft., From — ft. to — ft.

What is the nearest source of possible contamination:

1 Septic tank 2 Sewer lines 3 Watertight sewer lines 4 Lateral lines 5 Cess pool 6 Seepage pit 7 Pit privy 8 Sewage lagoon 9 Feedyard 10 Livestock pens 11 Fuel storage 12 Fertilizer storage 13 Insecticide storage 14 Abandoned water well 15 Oil well/Gas well 16 Other (specify below) HOUSE ROOF DRAIN

Direction from well? S - UP SLOPE How many feet? 15' SUB SURFACE

FROM	TO	LITHOLOGIC LOG	FROM	TO	PLUGGING INTERVALS
		NO RECORDS - DRILLED - 1969			

7 CONTRACTOR'S OR LANDOWNER'S CERTIFICATION: This water well was (1) constructed, (2) reconstructed, or (3) plugged under my jurisdiction and was completed on (mo/day/year) 07-16-88 and this record is true to the best of my knowledge and belief. Kansas Water Well Contractor's License No. 479 This Water Well Record was completed on (mo/day/yr) 07-29-88 under the business name of EBBERTS DRILLING by (signature) Gregory Ebberts

INSTRUCTIONS: Use typewriter or ball point pen. *PLEASE PRESS FIRMLY* and *PRINT* clearly. Please fill in blanks, underline or circle the correct answers. Send top three copies to Kansas Department of Health and Environment, Bureau of Water Protection, Topeka, Kansas 66620-7320. Telephone: 913-296-5514. Send one to WATER WELL OWNER and retain one for your records.