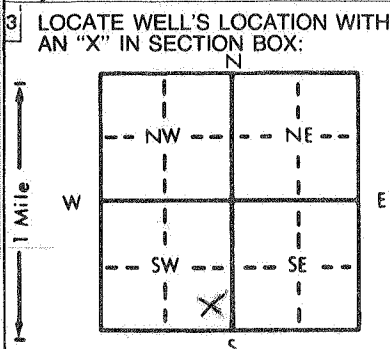


1 LOCATION OF WATER WELL: County: **LYDN** Fraction: **SE 1/4 SE 1/4 SW 1/4** Section Number: **12** Township Number: **T 19 S** Range Number: **R 11 (EW)**

Distance and direction from nearest town or city street address of well if located within city?  
**1/2 M. E OF WEAVER ST - NORTH of 6TH ST EMPORIA KS**

2 WATER WELL OWNER: **JERRY - DARIS BEDNER**  
 RR#, St. Address, Box #: **2302 E 6TH** Board of Agriculture, Division of Water Resource  
 City, State, ZIP Code: **EMPORIA KS 66801** Application Number:



4 DEPTH OF COMPLETED WELL: **40** ft. ELEVATION: **-**  
 Depth(s) Groundwater Encountered 1. **12** ft. 2. **-** ft. 3. **-** ft.  
 WELL'S STATIC WATER LEVEL: **30.5** ft. below land surface measured on mo/day/yr **07-14-88**  
 Pump test data: Well water was **-** ft. after **-** hours pumping **-** gpm  
 Est. Yield: **5** gpm Well water was **-** ft. after **-** hours pumping **-** gpm  
 Bore Hole Diameter: **10** in. to **11** ft., and **30** in. to **26** ft.  
 WELL WATER TO BE USED AS:  
 1 Domestic  3 Feedlot  5 Public water supply  8 Air conditioning  11 Injection well   
 2 Irrigation  4 Industrial  7 Lawn and garden only  9 Dewatering  12 Other (Specify below)   
 10 Monitoring well   
 Was a chemical/bacteriological sample submitted to Department? Yes  No  If yes, mo/day/yr sample was submitted **-**  
 Water Well Disinfected? Yes  No

5 TYPE OF BLANK CASING USED:  
 1 Steel  3 RMP (SR)  5 Wrought iron  8 Concrete tile  CASING JOINTS: Glued  Clamped   
 2 PVC  4 ABS  6 Asbestos-Cement  9 Other (specify below)  Welded   
 7 Fiberglass  Threaded   
 Blank casing diameter: **5** in. to **40** ft., Dia: **-** in. to **-** ft. Wall thickness or gauge No.: **SCH 40**  
 Casing height above land surface: **40** in., weight: **200** lbs./ft.

TYPE OF SCREEN OR PERFORATION MATERIAL:  
 1 Steel  3 Stainless steel  5 Fiberglass  7 PVC  10 Asbestos-cement   
 2 Brass  4 Galvanized steel  6 Concrete tile  8 RMP (SR)  11 Other (specify)   
 12 None used (open hole)

SCREEN OR PERFORATION OPENINGS ARE:  
 1 Continuous slot  3 Mill slot  5 Gauzed wrapped  8 Saw cut  11 None (open hole)   
 2 Louvered shutter  4 Key punched  6 Wire wrapped  9 Drilled holes   
 7 Torch cut  10 Other (specify)   
 SCREEN-PERFORATED INTERVALS: From **32** ft. to **40** ft., From **12** ft. to **16** ft.  
 From **-** ft. to **-** ft., From **-** ft. to **-** ft.  
 GRAVEL PACK INTERVALS: From **11** ft. to **40** ft., From **2 1/2 TONS** to **-** ft.  
 From **-** ft. to **-** ft., From **-** ft. to **-** ft.

6 GROUT MATERIAL: 1 Neat cement  2 Cement grout  3 Bentonite  4 Other   
 Grout Intervals: From **GL** #. to **8** ft., From **8** ft. to **11** ft., From **-** ft. to **-** ft.  
 What is the nearest source of possible contamination:  
 1 Septic tank  4 Lateral lines  7 Pit privy  10 Livestock pens  14 Abandoned water well   
 2 Sewer lines  5 Cess pool  8 Sewage lagoon  11 Fuel storage  15 Oil well/Gas well   
 3 Watertight sewer lines  6 Seepage pit  9 Feedyard  12 Fertilizer storage  16 Other (specify below)   
 13 Insecticide storage   
 Direction from well? \* **-** How many feet? \* **-**

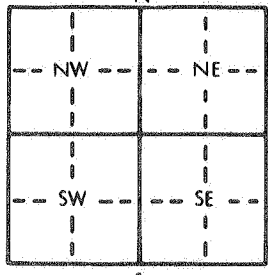
FROM	TO	LITHOLOGIC LOG	FROM	TO	PLUGGING INTERVALS
6L	12	GREY SILT		*	PHONE - TAYLOR & PLUMMER
12	-	WATER			7-14-88
12	26	SILT-CLAY - REDISH			
26	30	SHALE			
30	35	LIME			
35	36	SLATE			
36	37	LIME			
37	40	LT GREY SHALE			
40	40	LIME			

7 CONTRACTOR'S OR LANDOWNER'S CERTIFICATION: This water well was (1) constructed, (2) reconstructed, or (3) plugged under my jurisdiction and was completed on (mo/day/year) **07-14-88** and this record is true to the best of my knowledge and belief. Kansas Water Well Contractor's License No. **479** This Water Well Record was completed on (mo/day/yr) **07-14-88** under the business name of **EBBERTS DRILLING** by (signature) *Gregor Ebberts*

1 LOCATION OF WATER WELL: Fraction  $\frac{1}{4}$   $\frac{1}{4}$   $\frac{1}{4}$  Section Number Township Number Range Number  
 County: St. Address, Box # : 2302 E 6 TH Board of Agriculture, Division of Water Resources  
 City, State, ZIP Code : EMPORIA KS 66801 Application Number:

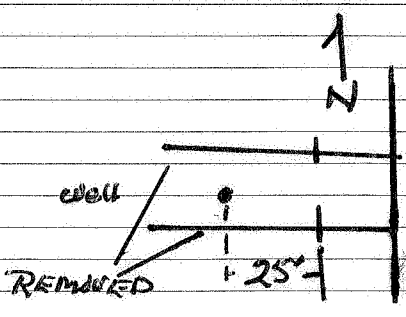
Distance and direction from nearest town or city street address of well if located within city?

2 WATER WELL OWNER: JERRY BEDNER  
 RR#, St. Address, Box # : 2302 E 6 TH  
 City, State, ZIP Code : EMPORIA KS 66801

3 LOCATE WELL'S LOCATION WITH AN "X" IN SECTION BOX:  
  
 4 DEPTH OF COMPLETED WELL: ft. ELEVATION:  
 Depth(s) Groundwater Encountered 1. ft. 2. ft. 3. ft.  
 WELL'S STATIC WATER LEVEL: ft. below land surface measured on mo/day/yr  
 Pump test data: Well water was ft. after hours pumping gpm  
 Est. Yield gpm: Well water was ft. after hours pumping gpm  
 Bore Hole Diameter: in. to ft., and in. to ft.  
 WELL WATER TO BE USED AS:  
 1 Domestic 3 Feedlot 5 Public water supply 8 Air conditioning 11 Injection well  
 2 Irrigation 4 Industrial 6 Oil field water supply 9 Dewatering 12 Other (Specify below)  
 7 Lawn and garden only 10 Monitoring well  
 Was a chemical/bacteriological sample submitted to Department? Yes.....No.....; If yes, mo/day/yr sample was submitted Water Well Disinfected? Yes No

5 TYPE OF BLANK CASING USED:  
 1 Steel 3 RMP (SR) 5 Wrought iron 8 Concrete tile CASING JOINTS: Glued Clamped  
 2 PVC 4 ABS 6 Asbestos-Cement 9 Other (specify below) Welded  
 7 Fiberglass Threaded  
 Blank casing diameter: in. to ft., Dia. in. to ft., Dia. in. to ft.  
 Casing height above land surface: in., weight lbs./ft. Wall thickness or gauge No.  
 TYPE OF SCREEN OR PERFORATION MATERIAL:  
 1 Steel 3 Stainless steel 5 Fiberglass 7 PVC 10 Asbestos-cement  
 2 Brass 4 Galvanized steel 6 Concrete tile 8 RMP (SR) 11 Other (specify)  
 9 ABS 12 None used (open hole)  
 SCREEN OR PERFORATION OPENINGS ARE:  
 1 Continuous slot 3 Mill slot 5 Gauzed wrapped 8 Saw cut 11 None (open hole)  
 2 Louvered shutter 4 Key punched 6 Wire wrapped 9 Drilled holes  
 7 Torch cut 10 Other (specify)  
 SCREEN-PERFORATED INTERVALS: From ft. to ft., From ft. to ft.  
 GRAVEL PACK INTERVALS: From ft. to ft., From ft. to ft.

6 GROUT MATERIAL: 1 Neat cement 2 Cement grout 3 Bentonite 4 Other  
 Grout Intervals: From ft. to ft., From ft. to ft., From ft. to ft.  
 What is the nearest source of possible contamination:  
 1 Septic tank 4 Lateral lines 7 Pit privy 10 Livestock pens 14 Abandoned water well  
 2 Sewer lines 5 Cess pool 8 Sewage lagoon 11 Fuel storage 15 Oil well/Gas well  
 3 Watertight sewer lines 6 Seepage pit 9 Feedyard 12 Fertilizer storage 16 Other (specify below)  
 13 Insecticide storage  
 Direction from well? N + S How many feet? 7' 8'

FROM	TO	LITHOLOGIC LOG	FROM	TO	PLUGGING INTERVALS
		<p>OLD LATERAL LINES WERE FOUND AFTER WELL WAS COMPLETED                      REF PH. D.P. STATE DEP. - NITRATE TEST RUN - 8.6                      LAT. WERE REMOVED 25 AWAY FROM WELL BORE - BACK FILLED WITH CLAY BASE SOIL - SURFACE RAISED AROUND WELL BORE.</p>			

7 CONTRACTOR'S OR LANDOWNER'S CERTIFICATION: This water well was (1) constructed, (2) reconstructed, or (3) plugged under my jurisdiction and was completed on (mo/day/year) and this record is true to the best of my knowledge and belief. Kansas Water Well Contractor's License No. This Water Well Record was completed on (mo/day/yr) under the business name of by (signature)