USE TYPEWRITER OR BALL POINT PEN-PRESS FIRMLY, PRINT CLEARLY.

WATER WELL RECORD
KSA 82a-1201-1215

Kansas Department of Health and Environment-Division of Environment
(Water well Contractors)
Topeka, Kansas 66620

1. Location of well:	County	Fraction	Section number	Township number	Range number
	Lyon	NW 1/4 NW 1/4 SW 1/4	13	T 19 S	R 11 E/W

2. Distance and direction from nearest town or city: 1/4 mi. E. of Emporia
Street address of well location if in city:

3. Owner of well: Kenneth Humphreys
R.R. or street: 918 Chestnut
City, state, zip code: Emporia, KS. 66801

4. Locate with "X" in section below:

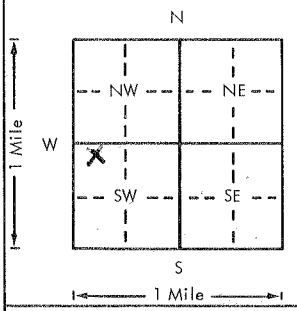

Sketch map:

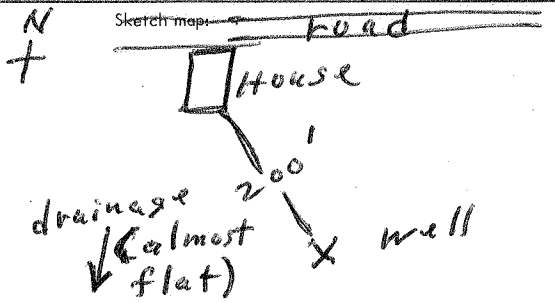

6. Bore hole dia. 6 in. Completion date 8-14-79
Well depth 90 ft.

7. ✓ Cable tool __ Rotary __ Driven __ Dug
__ Hollow rod __ Jetted __ Bored __ Reverse rotary

8. Use: ✓ Domestic __ Public supply __ Industry
__ Irrigation __ Air conditioning __ Stock
__ Lawn __ Oil field water __ Other

9. Casing: Material Pl. Height: Above or below
Threaded ___ Welded Gl. Surface 24 in.
RMP ✓ PVC ___ Weight 1.5 lbs./ft.
Dia. 5 in. to 90 ft. depth Wall Thickness: inches or
Dia. ___ in. to ___ ft. depth gage No. .200

5. Type and color of material	From	To
Brown clay	0	3
Tan clay or silt	3	30
Gravel and clay	30	32
Tan rock (cemented sand-	32	36
stone or a limestone?;		
very hard)		
Tan clay with rock	36	38
Blue shale with tan sand layers	38	53
Tan rock (limestone)	53	57
Gray shale with tan sand layers	57	59
Tan rock (limestone)	59	67
Gray shale with tan sand layers	67	71
Tan rock and shale	71	76
Gray shale with sand (tan)	76	77
White rock (limestone)	77	81
Tan shale	81	85
Tan rock and shale	85	88
Gray shale (Use a second sheet if needed)	88	90

10. Screen: Manufacturer's name Cer Mac
Type RMP Dia. 5"
Slot/gauze .06 Length 60'
Set between 30 ft. and 90 ft.
___ ft. and ___ ft.
Gravel pack? ✓ Size range of material 1/4-1/2

11. Static water level: mo./day/yr.
28 ft. below land surface Date 8-14-79

12. Pumping level below land surfaces:
___ ft. after ___ hrs. pumping ___ g.p.m.
___ ft. after ___ hrs. pumping ___ g.p.m.
Estimated maximum yield 2/3 g.p.m.

13. Water sample submitted: mo./day/yr.
___ Yes ✓ No Date

14. Well head completion:
___ Pitless adapter 24 Inches above grade

15. Well grouted? yes
With: ___ Neat cement ___ Bentonite ✓ Concrete
Depth: From 0 ft. to 10 ft.

16. Nearest source of possible contamination:
ft. 200 Direction NW Type Septic
Well disinfected upon completion? ✓ Yes ___ No

17. Pump: ✓ Not installed
Manufacturer's name
Model number ___ HP ___ Volts ___
Length of drop pipe ___ ft. capacity ___ g.p.m.
Type:
___ Submersible ___ Turbine
___ Jet ___ Reciprocating
___ Centrifugal ___ Other

18. Elevation:
Topography: flat
___ Hill
___ Slope
___ Upland
___ Valley

19. Remarks:
The small yield of water is coming in at 32 ft.
Owner will install concrete slab.
" plans to install jet pump.
Well stores about 375 gallon.

20. Water well contractor's certification:
This well was drilled under my jurisdiction and this report is true to the best of my knowledge and belief. 372
Business name Lespagnard W.W. Contr License No.
Address 1312 Trail Ridge Rd., Emp
Signed Gerald Lespagnard Date 8-19-
Authorized representative

T 19 S R 11 E/W Sec 1/4 1/4 1/4

Forward the white, blue and pink copies to the Department of Health and Environment

Form WWC-5

M1-1023