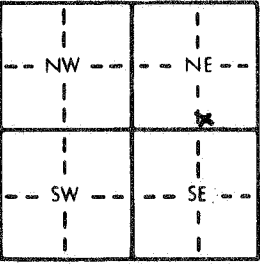
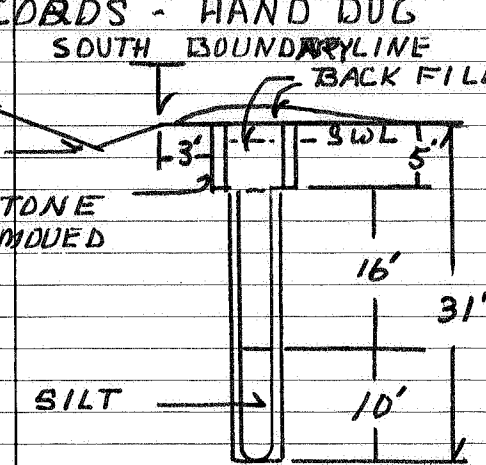


1 LOCATION OF WATER WELL: County: <b>LYDN</b>		Fraction: <b>SW 1/4 NE 1/4</b>	Section Number: <b>14</b>	Township Number: <b>T 19 S</b>	Range Number: <b>R 4 E</b>
Distance and direction from nearest town or city street address of well if located within city? <b>1408 E S AVE EMPORIA KS 66801</b>					
2 WATER WELL OWNER: <b>JAMES H. BLODM TRUST</b> RR#, St. Address, Box #: <b>1816 SO. 40TH STREET</b> City, State, ZIP Code: <b>ST. JOSEPH MO. 64507</b> Board of Agriculture, Division of Water Resources Application Number:					
3 LOCATE WELL'S LOCATION WITH AN "X" IN SECTION BOX: 		4 DEPTH OF COMPLETED WELL: <b>31</b> ft. ELEVATION: <b>-</b> ft. Depth(s) Groundwater Encountered <b>1. UNKN DWN</b> ft. 2. <b>-</b> ft. 3. <b>-</b> ft. WELL'S STATIC WATER LEVEL <b>1</b> ft. below land surface measured on mo/day/yr <b>04-22-92</b> Pump test data: Well water was <b>-</b> ft. after <b>-</b> hours pumping <b>-</b> gpm Est. Yield <b>1/2</b> gpm: Well water was <b>-</b> ft. after <b>-</b> hours pumping <b>-</b> gpm Bore Hole Diameter <b>10 50</b> in. to <b>5</b> ft. and <b>10 36</b> in. to <b>31</b> ft. WELL WATER TO BE USED AS: 1 Domestic 3 Feedlot 6 Oil field water supply 9 Dewatering 12 Other (Specify below) <b>ABANDONED</b> 2 Irrigation 4 Industrial 7 Lawn and garden only 10 Monitoring well Was a chemical/bacteriological sample submitted to Department? Yes <b>-</b> No <b>X</b> ; If yes, mo/day/yr sample was submitted <b>-</b> Water Well Disinfected? Yes <b>X</b> No <b>-</b>			
5 TYPE OF BLANK CASING USED: 1 Steel 3 RMP (SR) 5 Wrought iron 8 Concrete tile CASING JOINTS: Glued <b>-</b> Clamped <b>-</b> 2 PVC 4 ABS 6 Asbestos-Cement 9 Other (specify below) <b>LIME STONE</b> Welded <b>-</b> Blank casing diameter <b>10 50</b> in. to <b>5</b> ft. Dia <b>10 36</b> in. to <b>31</b> ft. Dia <b>-</b> in. to <b>-</b> ft. Casing height above land surface <b>LEVEL</b> in. weight <b>-</b> lbs./ft. Wall thickness or gauge No. <b>-</b> TYPE OF SCREEN OR PERFORATION MATERIAL: <b>NA</b> 7 PVC 10 Asbestos-cement 1 Steel 3 Stainless steel 5 Fiberglass 8 RMP (SR) 11 Other (specify) <b>-</b> 2 Brass 4 Galvanized steel 6 Concrete tile 9 ABS 12 None used (open hole) SCREEN OR PERFORATION OPENINGS ARE: <b>NA</b> 5 Gauzed wrapped 8 Saw cut 11 None (open hole) 1 Continuous slot 3 Mill slot 6 Wire wrapped 9 Drilled holes 2 Louvered shutter 4 Key punched 7 Torch cut 10 Other (specify) <b>-</b> SCREEN-PERFORATED INTERVALS: From <b>NA</b> ft. to <b>-</b> ft. From <b>-</b> ft. to <b>-</b> ft. From <b>-</b> ft. to <b>-</b> ft. GRAVEL PACK INTERVALS: From <b>6</b> ft. to <b>21</b> ft. From <b>-</b> ft. to <b>-</b> ft. From <b>-</b> ft. to <b>-</b> ft.					
6 GROUT MATERIAL: 1 Neat cement 2 Cement grout 3 Bentonite 4 Other <b>-</b> Grout Intervals: From <b>4.5</b> ft. to <b>5</b> ft. From <b>-</b> ft. to <b>-</b> ft. From <b>-</b> ft. to <b>-</b> ft. What is the nearest source of possible contamination: 1 Septic tank 4 Lateral lines 7 Pit privy 10 Livestock pens 14 Abandoned water well 2 Sewer lines 5 Cess pool 8 Sewage lagoon 11 Fuel storage 15 Oil well/Gas well 3 Watertight sewer lines 6 Seepage pit 9 Feedyard 12 Fertilizer storage 16 Other (specify below) <b>-</b> 13 Insecticide storage <b>-</b> Direction from well? <b>NW</b> How many feet? <b>35</b>					
FROM TO LITHOLOGIC LOG		FROM TO PLUGGING INTERVALS			
<b>NO RECORDS - HAND DUG</b> <b>SOUTH BOUNDARY LINE</b> <b>ROAD</b> <b>DITCH</b> <b>LIME STONE WALL - REMOVED</b> <b>SILT</b> 		<b>* THE WELL BORE HAD TO BE 80" TO 5' AND 65" TO 31' TO HANDLE THE SIZE OF LIMESTONE THAT WAS USED.</b>			
7 CONTRACTOR'S OR LANDOWNER'S CERTIFICATION: This water well was (1) constructed, (2) reconstructed, or (3) <u>plugged</u> under my jurisdiction and was completed on (mo/day/year) <b>04-24-92</b> and this record is true to the best of my knowledge and belief. Kansas Water Well Contractor's License No. <b>479</b> This Water Well Record was completed on (mo/day/yr) <b>04-29-92</b> under the business name of <b>EBBERTS DRILLING</b> by (signature) <i>Luoyan M. Ebberts</i>					