


1 LOCATION OF WATER WELL: County: LYON Fraction: SE 1/4 SE 1/4 NE 1/4 Section Number: 14 Township Number: T19 N S Range Number: R 19 E/W

Distance and direction from nearest town or city street address of well if located within city?  
20' W of NW COR OF BARN - 303 WEAVER - EMPORIA KS

2 WATER WELL OWNER: STEVE K. WILSON  
 RR#, St. Address, Box #: 303 WEAVER Board of Agriculture, Division of Water Resources  
 City, State, ZIP Code: EMPORIA KS 66801 Application Number: -

3 LOCATE WELL'S LOCATION WITH AN "X" IN SECTION BOX:

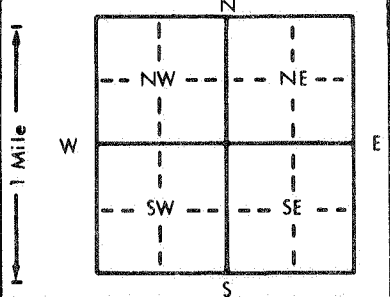

4 DEPTH OF COMPLETED WELL: 37 ft. ELEVATION: -  
 Depth(s) Groundwater Encountered 1. UNKNOWN ft. 2. - ft. 3. - ft.  
 WELL'S STATIC WATER LEVEL: 20 ft. below land surface measured on mo/day/yr 07-24-92  
 Pump test data: Well water was - ft. after - hours pumping - gpm  
 Est. Yield ? gpm: Well water was - ft. after - hours pumping - gpm  
 Bore Hole Diameter: 8 in. to 3.7 ft., and - in. to - ft.  
 WELL WATER TO BE USED AS:  
 1 Domestic 3 Feedlot 6 Oil field water supply 9 Dewatering 12 Other (Specify below)  
 2 Irrigation 4 Industrial 7 Lawn and garden only 10 Monitoring well  
 Was a chemical/bacteriological sample submitted to Department? Yes - No X; If yes, mo/day/yr sample was submitted -  
 Water Well Disinfected? Yes X No -

5 TYPE OF BLANK CASING USED:  
 1 Steel 3 RMP (SR) 5 Wrought iron 8 Concrete tile CASING JOINTS: Glued - Clamped -  
 2 PVC 4 ABS 6 Asbestos-Cement 9 Other (specify below) SNAP Welded -  
 7 Fiberglass GALV-TEN Threaded -

Blank casing diameter: 6 in. to 3.7 ft., Dia. - in. to - ft., Dia. - in. to - ft.  
 Casing height above land surface: 28 in., weight - lbs./ft. Wall thickness or gauge No. -

TYPE OF SCREEN OR PERFORATION MATERIAL:  
 1 Steel 3 Stainless steel 5 Fiberglass 8 RMP (SR) 10 Asbestos-cement 11 Other (specify) -  
 2 Brass 4 Galvanized steel 6 Concrete tile 9 ABS 12 None used (open hole)

SCREEN OR PERFORATION OPENINGS ARE:  
 1 Continuous slot 3 Mill slot 5 Gauzed wrapped 8 Saw cut 11 None (open hole)  
 2 Louvered shutter 4 Key punched 6 Wire wrapped 9 Drilled holes  
 7 Torch cut 10 Other (specify) -

SCREEN-PERFORATED INTERVALS: X From UNKNOWN ft. to - ft., From - ft. to - ft., From - ft. to - ft.  
 GRAVEL PACK INTERVALS: X From NOT USED ft. to - ft., From - ft. to - ft., From - ft. to - ft.

6 GROUT MATERIAL: BX 1 Neat cement 2 Cement grout 3 Bentonite 4 Other -  
 Grout Intervals: From 5 ft. to 5 ft., From 17 ft. to 20 ft., From - ft. to - ft.

What is the nearest source of possible contamination:  
 1 Septic tank 4 Lateral lines 7 Pit privy 10 Livestock pens 14 Abandoned water well  
 2 Sewer lines 5 Cess pool 8 Sewage lagoon 11 Fuel storage 15 Oil well/Gas well  
 3 Watertight sewer lines 6 Seepage pit 9 Feedyard 12 Fertilizer storage 16 Other (specify below)  
 13 Insecticide storage  
 Direction from well? - How many feet? -

| FROM | TO | LITHOLOGIC LOG  | FROM      | TO        | PLUGGING INTERVALS |
|------|----|---|-----------|-----------|--------------------|
|      |    | <u>* NO RECORDS - NEIGHBOR WITNESS:</u>                             |           |           |                    |
|      |    | <u>WELL WAS DUG WITH POST AUGER - 1952</u>                          |           |           |                    |
|      |    | <u>NO GRAVEL PACK OR GROUT WAS USED IN CONSTRUCTION.</u>            |           |           |                    |
|      |    | <u>WELL PRODUCED LESS THAN 100 GPD DAY FOR GARDEN. - HAND PUMP.</u> |           |           |                    |
|      |    | <u>ABANDONED - 1970'S - OPEN TOP SET IN 2 CONCRETE SLABS</u>        |           |           |                    |
|      |    | <u>WITH A LAYER OF BRICK IN BETWEEN -</u>                           |           |           |                    |
|      |    | <u>THE 5' SQ (CONCRETE AND BRICK) WAS REMOVED WHEN PLUGGED.</u>     |           |           |                    |
|      |    | <u>BX WELL WAS FILLED WITH SAND &amp; GRAVEL TO SWL - 1 BAG</u>     |           |           |                    |
|      |    | <u>BENTONITE ON TOP OF FILL - THEN FILLED WITH CLAY AND</u>         |           |           |                    |
|      |    | <u>OTHER FILL MATERIAL TO 5'. THEN A BENTONITE FILL TO</u>          |           |           |                    |
|      |    | <u>1.5 FT - BALANCE FILLED WITH SOIL AND CLAY</u>                   |           |           |                    |
|      |    | <u>INCLUDING THE AREA WHERE THE SLABS WERE REMOVED.</u>             |           |           |                    |
|      |    |   | <u>37</u> | <u>20</u> | <u>Sand Gravel</u> |
|      |    |   | <u>20</u> | <u>1</u>  | <u>Bentonite</u>   |

7 CONTRACTOR'S OR LANDOWNER'S CERTIFICATION: This water well was (1) constructed, (2) reconstructed, or (3) plugged under my jurisdiction and was completed on (mo/day/year) 07-24-92 and this record is true to the best of my knowledge and belief. Kansas Water Well Contractor's License No. 479 This Water Well Record was completed on (mo/day/yr) 07-26-92 under the business name of EBBERTS DRILLING by (signature) Augusta Welbert

INSTRUCTIONS: Use typewriter or ball point pen. PLEASE PRESS FIRMLY and PRINT clearly. Please fill in blanks, underline or circle the correct answers. Send top three copies to Kansas Department of Health and Environment, Bureau of Water, Topeka, Kansas 66620-0001. Telephone: 913-296-5545. Send one to WATER WELL OWNER and retain one for your records.