


1] LOCATION OF WATER WELL: Fraction NE 1/4 NW 1/4 NW 1/4 Section Number 14 Township Number T 19 S Range Number R 11 EW
 County: Lyon

Distance and direction from nearest town or city street address of well if located within city?
Lakeview 66, 812 E. 6th, Emporia, Ks.

2] WATER WELL OWNER: Jim Shephard
 RR#, St. Address, Box # : 812 E. 6th Board of Agriculture, Division of Water Resources
 City, State, ZIP Code : Emporia, KS. Application Number:

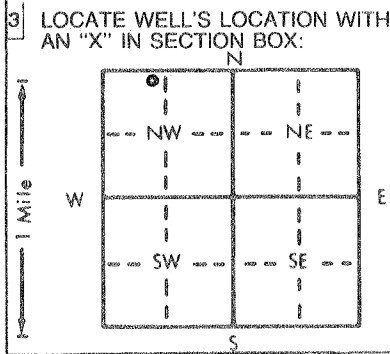

4] DEPTH OF COMPLETED WELL: 25' ft. ELEVATION: ft.
 Depth(s) Groundwater Encountered 1. 21' ft. 2. ft. 3. ft.
 WELL'S STATIC WATER LEVEL 18.79' ft. below land surface measured on mo/day/yr 4-26-94
 Pump test data: Well water was ft. after hours pumping gpm
 Est. Yield gpm: Well water was ft. after hours pumping gpm
 Bore Hole Diameter: 8 1/2' in. to 25' ft., and in. to ft.
 WELL WATER TO BE USED AS: 5 Public water supply 8 Air conditioning 11 Injection well
 1 Domestic 3 Feedlot 6 Oil field water supply 9 Dewatering 12 Other (Specify below)
 2 Irrigation 4 Industrial 7 Lawn and garden only 10 Monitoring well
 Was a chemical/bacteriological sample submitted to Department? Yes.....No X.....; If yes, mo/day/yr sample was submitted
 Water Well Disinfected? Yes No

5] TYPE OF BLANK CASING USED: 5 Wrought iron 8 Concrete tile CASING JOINTS: Glued Clamped
 1 Steel 3 RMP (SR) 6 Asbestos-Cement 9 Other (specify below) Welded
2 PVC 4 ABS 7 Fiberglass Threaded X
 Blank casing diameter 2.375 in. to 10' ft., Dia in. to ft., Dia in. to ft.
 Casing height above land surface Flush Mount in., weight lbs./ft. Wall thickness or gauge No. Sdr 13
 TYPE OF SCREEN OR PERFORATION MATERIAL: 7 PVC 10 Asbestos-cement Sch 40
 1 Steel 3 Stainless steel 5 Fiberglass 8 RMP (SR) 11 Other (specify)
 2 Brass 4 Galvanized steel 6 Concrete tile 9 ABS 12 None used (open hole)
 SCREEN OR PERFORATION OPENINGS ARE: 5 Gauzed wrapped 8 Saw cut 11 None (open hole)
 1 Continuous slot 3 Mill slot 6 Wire wrapped 9 Drilled holes
 2 Louvered shutter 4 Key punched 7 Torch cut 10 Other (specify)
 SCREEN-PERFORATED INTERVALS: From 25' ft. to 10' ft., From ft. to ft.
 GRAVEL PACK INTERVALS: From 25' ft. to 8' ft., From ft. to ft.

6] GROUT MATERIAL: 1 Neat cement 2 Cement grout 3 Bentonite 4 Other
 Grout Intervals: From 8' ft. to 4' ft., From 4' ft. to 0' ft., From ft. to ft.
 What is the nearest source of possible contamination: 10 Livestock pens 14 Abandoned water well
 1 Septic tank 4 Lateral lines 7 Pit privy 11 Fuel storage 15 Oil well/Gas well
 2 Sewer lines 5 Cess pool 8 Sewage lagoon 12 Fertilizer storage 16 Other (specify below)
 3 Watertight sewer lines 6 Seepage pit 9 Feedyard 13 Insecticide storage
 Direction from well? North-Northwest How many feet? 150'

FROM	TO	LITHOLOGIC LOG	FROM	TO	PLUGGING INTERVALS
0	2	Grass- dry brn gravel, packed, no odor.			
2	8	Dk gray-blk clay, tight, no odor, iron oxide staining & mottling.			
8	13.75	Red orange brn stiff clay w/ gray clay mottling, moist, no odor, iron oxides.			
13.75	16.50	Grayish brn clayey silt, moist, slight odor, mottled.			
16.50	25	Grayish tan brn silty sandy clay, moist to wet, mod. odor. Wet at 21'			

7] CONTRACTOR'S OR LANDOWNER'S CERTIFICATION: This water well was (1) constructed (2) reconstructed, or (3) plugged under my jurisdiction and was completed on (mo/day/year) 4-26-94 and this record is true to the best of my knowledge and belief. Kansas Water Well Contractor's License No. 539 This Water Well Record was completed on (mo/day/yr) 4/29/94 under the business name of JB Environmental Drilling by (signature) James Belker