


1 LOCATION OF WATER WELL: County: **LYON** Fraction: **SE 1/4 SE 1/4 SW 1/4** Section Number: **15** Township Number: **T 19 S** Range Number: **R 11 EW**

Distance and direction from nearest town or city street address of well if located within city?
517 COTTONWOOD-EMPORIA KS

2 WATER WELL OWNER: **LESTER CLEMENTS ROUTE 4**
 RR#, St. Address, Box #: **BOX 715 TEXARKANA ARK 75502** Board of Agriculture, Division of Water Resource
 City, State, ZIP Code: **TEXARKANA ARK 75502** Application Number:

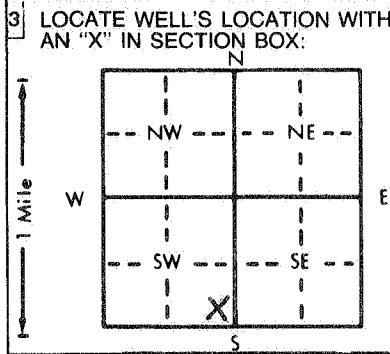

4 DEPTH OF COMPLETED WELL: **UNKNOWN** ft. ELEVATION: _____
 Depth(s) Groundwater Encountered: **UNKNOWN** ft. 2. _____ ft. 3. _____ ft.
 WELL'S STATIC WATER LEVEL: **10.5** ft. below land surface measured on mo/day/yr: **06-19-92**
 Pump test data: Well water was _____ ft. after _____ hours pumping _____ gpm
 Est. Yield _____ gpm: Well water was _____ ft. after _____ hours pumping _____ gpm
 Bore Hole Diameter: **60-70** in. to _____ **13** ft., and **UNKNOWN** in. to **UNKNOWN** ft.
 WELL WATER TO BE USED AS:
 1 Domestic 3 Feedlot 6 Oil field water supply 9 Dewatering 12 Other (Specify below) **PLUGGED**
 2 Irrigation 4 Industrial 7 Lawn and garden only 10 Monitoring well
 Was a chemical/bacteriological sample submitted to Department? Yes _____ No ; If yes, mo/day/yr sample was submitted _____
 Water Well Disinfected? Yes No _____

5 TYPE OF BLANK CASING USED:
 * 1 Steel 3 RMP (SR)
 2 PVC 4 ABS
 5 Wrought iron 8 Concrete tile CASING JOINTS: Glued _____ Clamped _____
 6 Asbestos-Cement 9 Other (specify below) _____ Welded _____
 7 Fiberglass Threaded _____
 Blank casing diameter _____ in. to _____ ft., Dia _____ in. to _____ ft., Dia _____ in. to _____ ft.
 Casing height above land surface _____ in. weight _____ lbs./ft. Wall thickness or gauge No. _____
 TYPE OF SCREEN OR PERFORATION MATERIAL: **NA**
 1 Steel 3 Stainless steel 5 Fiberglass 7 PVC 10 Asbestos-cement
 2 Brass 4 Galvanized steel 6 Concrete tile 8 RMP (SR) 11 Other (specify) _____
 9 ABS 12 None used (open hole)
 SCREEN OR PERFORATION OPENINGS ARE:
 1 Continuous slot 3 Mill slot 5 Gauzed wrapped 8 Saw cut 11 None (open hole)
 2 Louvered shutter 4 Key punched 6 Wire wrapped 9 Drilled holes
 7 Torch cut 10 Other (specify) _____
 SCREEN-PERFORATED INTERVALS: From _____ ft. to _____ ft., From _____ ft. to _____ ft., From _____ ft. to _____ ft.
 GRAVEL PACK INTERVALS: From **13** ft. to **UNKNOWN** ft., From _____ ft. to _____ ft., From _____ ft. to _____ ft.

6 GROUT MATERIAL: 1 Neat cement 2 Cement grout 3 Bentonite 4 Other _____
 Grout Intervals: From **4** ft. to **S** ft., From _____ ft. to _____ ft., From _____ ft. to _____ ft.
 What is the nearest source of possible contamination:
 1 Septic tank 4 Lateral lines 7 Pit privy 10 Livestock pens 14 Abandoned water well
 2 Sewer lines 5 Cess pool 8 Sewage lagoon 11 Fuel storage 15 Oil well/Gas well
 3 Watertight sewer lines 6 Seepage pit 9 Feedyard 12 Fertilizer storage 16 Other (specify below) _____
 13 Insecticide storage
 Direction from well? **S** How many feet? **5'**

FROM	TO	LITHOLOGIC LOG	FROM	TO	PLUGGING INTERVALS
	*	NO RECORDS - THIS WAS A ABANDONED HAND DUG - LIME STONE WALL WATER WELL:			
		AS FOUND CONDITION: 13 FT TO BOTTOM, TEST OF MATERIAL IN BOTTOM INDICATED TO BE FILL MATERIAL OF SAND, GRAVEL AND LIMESTONE ROCK - TOTAL DEPTH OF WELL UNKNOWN - STATIC WATER LEVEL 10.5'. 1 FT CONCRETE ON TOP OF WELL WALL WAS BROKEN AND SOME PARTS FALLEN IN - TOP HAD SEVERAL OPEN AREAS - WALLS FALLING IN - SURFACE WATER RAN IN.			

7 CONTRACTOR'S OR LANDOWNER'S CERTIFICATION: This water well was (1) constructed, (2) reconstructed, or (3) plugged under my jurisdiction and was completed on (mo/day/year) **06-19-92** and this record is true to the best of my knowledge and belief. Kansas Water Well Contractor's License No. **479** This Water Well Record was completed on (mo/day/yr) **06-22-92** under the business name of **EBBERTS DRILLING** by (signature) *Arayan Ebberts*