


1 LOCATION OF WATER WELL: Fraction NW 1/4 NW 1/4 NW 1/4 Section Number 15 Township Number T 19 S Range Number R 11 EW
 County: LYON

Distance and direction from nearest town or city street address of well if located within city?
409 TRURAL EMPORIA

2 WATER WELL OWNER: EUREKA SAVINGS BANK - FSB
 RR#, St. Address, Box #: 701 MERCHANT Board of Agriculture, Division of Water Resource
 City, State, ZIP Code: EMPORIA KS 66801 Application Number: ---

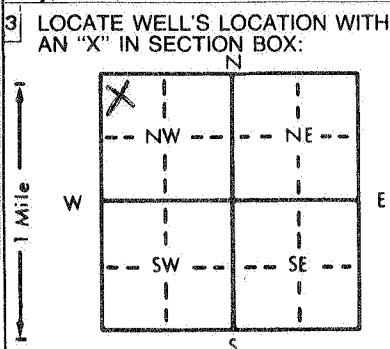

4 DEPTH OF COMPLETED WELL: UNKNOWN ft. ELEVATION: ---
 Depth(s) Groundwater Encountered: UNKNOWN ft. 2. --- ft. 3. --- ft.
 WELL'S STATIC WATER LEVEL: UNKNOWN ft. below land surface measured on mo/day/yr ---
 Pump test data: Well water was --- ft. after --- hours pumping --- gpm
 Est. Yield --- gpm: Well water was --- ft. after --- hours pumping --- gpm
 Bore Hole Diameter: 60 in. to --- ft., and --- in. to --- ft.
 WELL WATER TO BE USED AS:
 1 Domestic 3 Feedlot 6 Oil field water supply 9 Dewatering 12 Other (Specify below)
 2 Irrigation 4 Industrial 7 Lawn and garden only 10 Monitoring well
 Was a chemical/bacteriological sample submitted to Department? Yes --- No X; If yes, mo/day/yr sample was submitted --- Water Well Disinfected? Yes --- No X

5 TYPE OF BLANK CASING USED:
 1 Steel 3 RMP (SR) 5 Wrought iron 8 Concrete tile CASING JOINTS: Glued --- Clamped ---
 2 PVC 4 ABS 6 Asbestos-Cement 9 Other (specify below) Welded ---
 Blank casing diameter: APPROX 60 in. to UNKNOWN ft., Dia --- in. to --- ft., Dia --- in. to --- ft.
 Casing height above land surface: NA in., weight --- lbs./ft. Wall thickness or gauge No. ---
 TYPE OF SCREEN OR PERFORATION MATERIAL:
 1 Steel 3 Stainless steel 5 Fiberglass 7 PVC 10 Asbestos-cement
 2 Brass 4 Galvanized steel 6 Concrete tile 8 RMP (SR) 11 Other (specify) L.S. ROCKS
 9 ABS 12 None used (open hole)
 SCREEN-PERFORATED OPENINGS ARE:
 1 Continuous slot 3 Mill slot 5 Gauzed wrapped 8 Saw cut 11 None (open hole)
 2 Louvered shutter 4 Key punched 6 Wire wrapped 9 Drilled holes
 7 Torch cut 10 Other (specify) NA
 SCREEN-PERFORATED INTERVALS: From UNKNOWN ft. to --- ft., From --- ft. to --- ft.
 GRAVEL PACK INTERVALS: From UNKNOWN ft. to --- ft., From --- ft. to --- ft.

6 GROUT MATERIAL: 1 Neat cement 2 Cement grout 3 Bentonite 4 Other ---
 Grout Intervals: From 4.4 ft. to 5.2 ft., From --- ft. to --- ft., From --- ft. to --- ft.
 What is the nearest source of possible contamination: NONE VISIBLE
 1 Septic tank 4 Lateral lines 7 Pit privy 10 Livestock pens 14 Abandoned water well
 2 Sewer lines 5 Cess pool 8 Sewage lagoon 11 Fuel storage 15 Oil well/Gas well
 3 Watertight sewer lines 6 Seepage pit 9 Feedyard 12 Fertilizer storage 16 Other (specify below)
 13 Insecticide storage NA
 Direction from well? --- How many feet? ---

FROM	TO	LITHOLOGIC LOG	FROM	TO	PLUGGING INTERVALS
		<u>HAND DUG WELL - AS FOUND.</u>	<u>4.4</u>	<u>5.2</u>	<u>BENTONITE</u>
		<u>WELL HAD BEEN FILLED WITH SAND</u>			
		<u>BY PERSON UNKNOWN AND TIME OR DATE</u>			
		<u>UNKNOWN - THE FILL HAD DROPPED APPROX.</u>			
		<u>4' - TAP WATER WAS USED FOR SETTLING THE</u>			
		<u>FILL - ALL LIMESTONE IN WALL WAS REMOVED</u>			
		<u>TO APPLY 7' - AND REMOVED FROM SITE</u>			
		<u>COULD NOT GET DEEPER DUE TO THE SIZE OF</u>			
		<u>TREE TRUNKS -</u>			

7 CONTRACTOR'S OR LANDOWNER'S CERTIFICATION: This water well was (1) constructed, (2) reconstructed, or (3) plugged under my jurisdiction and was completed on (mo/day/year) 10-01-96 and this record is true to the best of my knowledge and belief. Kansas Water Well Contractor's License No. 479 This Water Well Record was completed on (mo/day/yr) 10-06-92 under the business name of EBBERTS DRILLING by (signature) [Signature]