


1 LOCATION OF WATER WELL: County: LYDN Fraction: NW 1/4 NW 1/4 SW 1/4 Section Number: 15 Township Number: T 19 S Range Number: R 11 EW

Distance and direction from nearest town or city street address of well if located within city?
41 S SYLVAN- EMPORIA KS

2 WATER WELL OWNER: FRED AND VICTORIA RODRIGUEZ
 RR#, St. Address, Box #: 41 S SYLVAN EMPORIA KS 66801
 City, State, ZIP Code: 66801
 Board of Agriculture, Division of Water Resources
 Application Number:

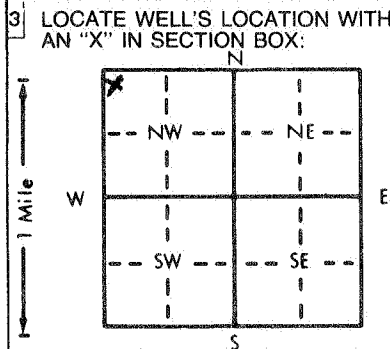

4 DEPTH OF COMPLETED WELL: 36 ft. ELEVATION: _____
 Depth(s) Groundwater Encountered: UNKNOWN ft. 2. _____ ft. 3. _____ ft.
 WELL'S STATIC WATER LEVEL: 20 ft. below land surface measured on mo/day/yr 03-20-93
 Pump test data: Well water was _____ ft. after _____ hours pumping _____ gpm
 Est. Yield NA gpm: Well water was _____ ft. after _____ hours pumping _____ gpm
 Bore Hole Diameter: 6 in. to PROB 30-32 ft., and _____ in. to _____ ft.
 WELL WATER TO BE USED AS:
 1 Domestic 3 Feedlot 6 Oil field water supply 9 Dewatering 12 Other (Specify below)
 2 Irrigation 4 Industrial 7 Lawn and garden only 10 Monitoring well _____
 Was a chemical/bacteriological sample submitted to Department? Yes _____ No X If yes, mo/day/yr sample was submitted _____
 Water Well Disinfected? Yes X No _____

5 TYPE OF BLANK CASING USED:
 1 Steel 3 RMP (SR) 5 Wrought iron 8 Concrete tile CASING JOINTS: Glued ? Clamped _____
2 PVC 4 ABS 6 Asbestos-Cement 9 Other (specify below) UNKNOWN Welded _____
 7 Fiberglass _____ Threaded ?
 Blank casing diameter: 5 in. to 36 ft., Dia _____ in. to _____ ft., Dia _____ in. to _____ ft.
 Casing height above land surface: 36 in., weight SCH 40 lbs./ft. Wall thickness or gauge No. _____
 TYPE OF SCREEN OR PERFORATION MATERIAL:
 1 Steel 3 Stainless steel 5 Fiberglass 8 RMP (SR) 10 Asbestos-cement
 2 Brass 4 Galvanized steel 6 Concrete tile 9 ABS 11 Other (specify) _____
 12 None used (open hole)
 SCREEN OR PERFORATION OPENINGS ARE:
 1 Continuous slot 3 Mill slot 5 Gauzed wrapped 8 Saw cut 11 None (open hole)
 2 Louvered shutter 4 Key punched 6 Wire wrapped 9 Drilled holes
 7 Torch cut 10 Other (specify) UNKNOWN
 SCREEN-PERFORATED INTERVALS: From UNKNOWN ft. to _____ ft., From _____ ft. to _____ ft.
 From _____ ft. to _____ ft., From _____ ft. to _____ ft.
 GRAVEL PACK INTERVALS: From UNKNOWN ft. to _____ ft., From _____ ft. to _____ ft.
 From _____ ft. to _____ ft., From _____ ft. to _____ ft.

6 GROUT MATERIAL: 1 Neat cement 2 Cement grout 3 Bentonite 4 Other NONE USED
 Grout Intervals: From NA ft. to _____ ft., From _____ ft. to _____ ft., From _____ ft. to _____ ft.
 What is the nearest source of possible contamination:
 1 Septic tank 4 Lateral lines 7 Pit privy 10 Livestock pens 14 Abandoned water well
 2 Sewer lines 5 Cess pool 8 Sewage lagoon 11 Fuel storage 15 Oil well/Gas well
 3 Watertight sewer lines 6 Seepage pit 9 Feedyard 12 Fertilizer storage 16 Other (specify below)
 Direction from well? EAST How many feet? 4'-5'
4'-5' FROM HOUSE

| FROM | TO | LITHOLOGIC LOG | FROM | TO | PLUGGING INTERVALS |
|------|----|-------------------------------------|------------|------------|-------------------------|
| | | <u>*NO RECORDS</u> | <u>0</u> | <u>3</u> | <u>DUG OUT</u> |
| | | <u>NO GROUT</u> | <u>0</u> | <u>2.5</u> | <u>TOPSOIL AND CLAY</u> |
| | | <u>PROBABLY DUG WITH POST AUGER</u> | <u>2.5</u> | <u>20</u> | <u>BENTONITE</u> |
| | | | <u>20</u> | <u>36</u> | <u>PEA GRAVEL</u> |

7 CONTRACTOR'S OR LANDOWNER'S CERTIFICATION: This water well was (1) constructed, (2) reconstructed, or (3) plugged under my jurisdiction and was completed on (mo/day/year) 03-20-93 and this record is true to the best of my knowledge and belief. Kansas Water Well Contractor's License No. 479 This Water Well Record was completed on (mo/day/yr) 03-29-93 under the business name of EBBERTS DRILLING by (signature) [Signature]