


1 LOCATION OF WATER WELL: Fraction NE 1/4 NW 1/4 NE 1/4 Section Number 16 Township Number T 19 S Range Number R 11 EW  
 County: Lyon

Distance and direction from nearest town or city street address of well if located within city?  
1703 W. 6th, Emporia, KS.

2 WATER WELL OWNER: Dale Weeks  
 RR#, St. Address, Box #: 1703 W. 6th Board of Agriculture, Division of Water Resources  
 City, State, ZIP Code: Emporia, Ks. Application Number:

3 LOCATE WELL'S LOCATION WITH AN "X" IN SECTION BOX:

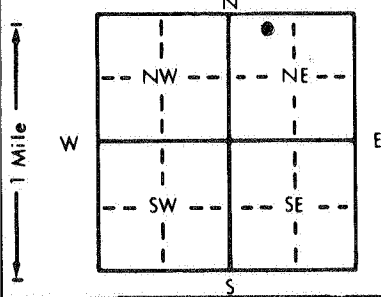

4 DEPTH OF COMPLETED WELL: 35' ft. ELEVATION: ..... ft.  
 Depth(s) Groundwater Encountered 1. 28' ft. 2. .... ft. 3. .... ft.  
 WELL'S STATIC WATER LEVEL 18.17 ft. below land surface measured on mo/day/yr 3-18-94  
 Pump test data: Well water was ..... ft. after ..... hours pumping ..... gpm  
 Est. Yield ..... gpm: Well water was ..... ft. after ..... hours pumping ..... gpm  
 Bore Hole Diameter: 8 1/2" in. to 35' ft., and ..... in. to ..... ft.  
 WELL WATER TO BE USED AS: 5 Public water supply 8 Air conditioning 11 Injection well  
 1 Domestic 3 Feedlot 6 Oil field water supply 9 Dewatering 12 Other (Specify below)  
 2 Irrigation 4 Industrial 7 Lawn and garden only  10 Monitoring well  
 Was a chemical/bacteriological sample submitted to Department? Yes.....No ; If yes, mo/day/yr sample was submitted  
 Water Well Disinfected? Yes  No

5 TYPE OF BLANK CASING USED: 5 Wrought iron 8 Concrete tile CASING JOINTS: Glued ..... Clamped .....  
 1 Steel 3 RMP (SR) 6 Asbestos-Cement 9 Other (specify below) Welded .....  
 2 PVC 4 ABS 7 Fiberglass Threaded

Blank casing diameter 2.375 in. to 20' ft., Dia ..... in. to ..... ft., Dia ..... in. to ..... ft.  
 Casing height above land surface Flush Mount in., weight ..... lbs./ft. Wall thickness or gauge No. SDR 13

TYPE OF SCREEN OR PERFORATION MATERIAL:  7 PVC 10 Asbestos-cement SCH 40  
 1 Steel 3 Stainless steel 5 Fiberglass 8 RMP (SR) 11 Other (specify) .....  
 2 Brass 4 Galvanized steel 6 Concrete tile 9 ABS 12 None used (open hole)

SCREEN OR PERFORATION OPENINGS ARE: 5 Gauzed wrapped 8 Saw cut 11 None (open hole)  
 1 Continuous slot  3 Mill slot 6 Wire wrapped 9 Drilled holes  
 2 Louvered shutter 4 Key punched 7 Torch cut 10 Other (specify) .....

SCREEN-PERFORATED INTERVALS: From 35' ft. to 20' ft., From ..... ft. to ..... ft.  
 From ..... ft. to ..... ft., From ..... ft. to ..... ft.  
 GRAVEL PACK INTERVALS: From 35' ft. to 18' ft., From ..... ft. to ..... ft.  
 From ..... ft. to ..... ft., From ..... ft. to ..... ft.

6 GROUT MATERIAL: 1 Neat cement 2 Cement grout 3 Bentonite 4 Other  
 Grout intervals: From 18' ft. to 4' ft., From 4' ft. to 0' ft., From ..... ft. to ..... ft.

What is the nearest source of possible contamination:  10 Livestock pens 14 Abandoned water well  
 1 Septic tank 4 Lateral lines 7 Pit privy  11 Fuel storage FOUR 15 Oil well/Gas well  
 2 Sewer lines 5 Cess pool 8 Sewage lagoon 12 Fertilizer storage 16 Other (specify below)  
 3 Watertight sewer lines 6 Seepage pit 9 Feedyard 13 Insecticide storage

Direction from well? west How many feet? 20'

FROM	TO	LITHOLOGIC LOG	FROM	TO	PLUGGING INTERVALS
0	2.25	Dk. brn rich organic soil, clayey, tight, earthy odor.			
2.25	5	Gray brn-yellowish brn mottled clay, silty, moist, no odor, iron oxides.			
5	14	Orange reddish brn silty clay w/gray clay mottling, moist, tight, no odor. Iron oxides. Dk brn-blk very thin banding, slight- mod. odor.			
14	19.50	Orange-brn silty clay, moist, tight w/gray clay mottling. Mod. odor.			
19.50	23	Grayish green mottled silty clay, moist, mod. odor, tight, iron oxides.			
23	27.50	Orange brn silty clay, iron oxides, mottled, moist, slight to mod. odor.			
27.50	35	olive green -yellow green silt-sandy silt. no odor.			

7 CONTRACTOR'S OR LANDOWNER'S CERTIFICATION: This water well was  (1) constructed, (2) reconstructed, or (3) plugged under my jurisdiction and was completed on (mo/day/year) 3-7-94 and this record is true to the best of my knowledge and belief. Kansas Water Well Contractor's License No. 539 This Water Well Record was completed on (mo/day/yr) 3-31-94 under the business name of JB Environmental Drilling by (signature) James Bieker

INSTRUCTIONS: Use typewriter or ball point pen. PLEASE PRESS FIRMLY and PRINT clearly. Please fill in blanks, underline or circle the correct answers. Send top three copies to Kansas Department of Health and Environment, Bureau of Water, Topeka, Kansas 66620-0001. Telephone: 913-296-5545. Send one to WATER WELL OWNER and retain one for your records.