


1 LOCATION OF WATER WELL: Fraction NW 1/4 SW 1/4 NW 1/4 Section Number 22 Township Number T 19 S Range Number R 11 E  
 County: Lyon

Distance and direction from nearest town or city street address of well if located within city?

1001 East Logan Ave.

2 WATER WELL OWNER: John Greer  
 RR#, St. Address, Box #: 1001 East Logan Ave  
 City, State, ZIP Code: Emporia KS 66801  
 Board of Agriculture, Division of Water Resources  
 Application Number: NA

3 LOCATE WELL'S LOCATION WITH AN "X" IN SECTION BOX: 4 DEPTH OF COMPLETED WELL: 46 ft. ELEVATION: \_\_\_\_\_  
 Depth(s) Groundwater Encountered 1. 13-17 ft. 2. 27-32 ft. 3. \_\_\_\_\_ ft.

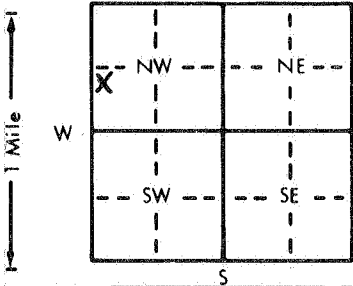

WELL'S STATIC WATER LEVEL: 11 ft. below land surface measured on mo/day/yr 8-3-83  
 Pump test data: Well water was \_\_\_\_\_ ft. after \_\_\_\_\_ hours pumping \_\_\_\_\_ gpm  
 Est. Yield: 2-3 gpm; Well water was \_\_\_\_\_ ft. after \_\_\_\_\_ hours pumping \_\_\_\_\_ gpm  
 Bore Hole Diameter: 10 in. to 20 ft., and 8 in. to 4.6 ft.  
 WELL WATER TO BE USED AS:  
 Domestic    3 Feedlot    6 Oil field water supply    9 Dewatering    12 Other (Specify below)  
 2 Irrigation    4 Industrial    7 Lawn and garden only    10 Observation well  
 Was a chemical/bacteriological sample submitted to Department? Yes \_\_\_\_\_ No X; If yes, mo/day/yr sample was submitted \_\_\_\_\_  
 Water Well Disinfected? Yes X No \_\_\_\_\_

5 TYPE OF BLANK CASING USED:  
 1 Steel    3 RMP (SR)    5 Wrought iron    8 Concrete tile    CASING JOINTS: Glued X Clamped \_\_\_\_\_  
 2 PVC    4 ABS    6 Asbestos-Cement    9 Other (specify below)    Welded \_\_\_\_\_  
 7 Fiberglass    Threaded \_\_\_\_\_

Blank casing diameter: 6 in. to 13 ft., Dia \_\_\_\_\_ in. to \_\_\_\_\_ ft., Dia \_\_\_\_\_ in. to \_\_\_\_\_ ft.  
 Casing height above land surface: 12 in., weight \_\_\_\_\_ lbs./ft. Wall thickness or gauge No. 16.0

TYPE OF SCREEN OR PERFORATION MATERIAL:  
 1 Steel    3 Stainless steel    5 Fiberglass    8 RMP (SR)    10 Asbestos-cement  
 2 Brass    4 Galvanized steel    6 Concrete tile    9 ABS    11 Other (specify) \_\_\_\_\_  
 12 None used (open hole)

SCREEN OR PERFORATION OPENINGS ARE:  
 1 Continuous slot    3 Mill slot    5 Gauzed wrapped    8 Saw cut    11 None (open hole)  
 2 Louvered shutter    4 Key punched    6 Wire wrapped    9 Drilled holes  
 7 Torch cut    10 Other (specify) \_\_\_\_\_

SCREEN-PERFORATED INTERVALS: From 13 ft. to 45 ft., From \_\_\_\_\_ ft. to \_\_\_\_\_ ft., From \_\_\_\_\_ ft. to \_\_\_\_\_ ft.  
 GRAVEL PACK INTERVALS: From 13 ft. to 45 ft., From \_\_\_\_\_ ft. to \_\_\_\_\_ ft., From \_\_\_\_\_ ft. to \_\_\_\_\_ ft.

6 GROUT MATERIAL:  Neat cement    2 Cement grout    3 Bentonite    4 Other \_\_\_\_\_  
 Grout Intervals: From 3 ft. to 13 ft., From \_\_\_\_\_ ft. to \_\_\_\_\_ ft., From \_\_\_\_\_ ft. to \_\_\_\_\_ ft.

What is the nearest source of possible contamination:  
 1 Septic tank    4 Lateral lines    7 Pit privy    10 Livestock pens    14 Abandoned water well  
 Sewer lines    5 Cess pool    8 Sewage lagoon    11 Fuel storage    15 Oil well/Gas well  
 3 Watertight sewer lines    6 Seepage pit    9 Feedyard    12 Fertilizer storage    16 Other (specify below)  
 13 Insecticide storage

Direction from well? South    How many feet? 50+

FROM	TO	LITHOLOGIC LOG	FROM	TO	LITHOLOGIC LOG
		<u>Old well No samples</u>			
		<u>Bed rock 19' Sand 13-17</u>			
		<u>Removed Galvanized Casing Reamed Hole Down &amp; re cased.</u>			

7 CONTRACTOR'S OR LANDOWNER'S CERTIFICATION: This water well was (1) constructed,  reconstructed, or (3) plugged under my jurisdiction and was completed on (mo/day/year) 8-3-83 and this record is true to the best of my knowledge and belief. Kansas Water Well Contractor's License No. 203 This Water Well Record was completed on (mo/day/yr) 8-3-83 under the business name of McNee Drilling & Metals by (signature) [Signature]

INSTRUCTIONS: Use typewriter or ball point pen, PLEASE PRESS FIRMLY and PRINT clearly. Please fill in blanks, underline or circle the correct answers. Send top three copies to Kansas Department of Health and Environment, Division of Environment, Environmental Geology Section, Topeka, KS 66620. Send one to WATER WELL OWNER and retain one for your records.