


1 LOCATION OF WATER WELL: Fraction NW 1/4 NW 1/4 NW 1/4 Section Number 23 Township Number T 419 S Range Number R 1911 EW  
 County: LYON

Distance and direction from nearest town or city street address of well if located within city?  
901 E LOGAN AVE - EMPORIA KS

2 WATER WELL OWNER: BOB AND BECKY LAMBERT  
 RR#, St. Address, Box # : 116 S CONSTITUTION ST - EMPORIA, KS 66801 Board of Agriculture, Division of Water Resource  
 City, State, ZIP Code : Application Number: 06-19-93

3 LOCATE WELL'S LOCATION WITH AN "X" IN SECTION BOX:

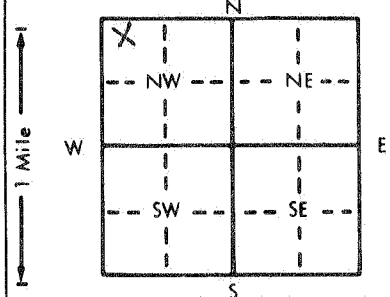

4 DEPTH OF COMPLETED WELL: UNKNOWN ft. ELEVATION: --- ft.  
 Depth(s) Groundwater Encountered 1. UNKNOWN ft. 2. --- ft. 3. --- ft.  
 WELL'S STATIC WATER LEVEL 17 ft. below land surface measured on mo/day/yr 02-19-93  
18 ft. below land surface measured on mo/day/yr 06-11-93

Pump test data: Well water was NA ft. after --- hours pumping --- gpm  
 Est. Yield NA gpm: Well water was --- ft. after --- hours pumping --- gpm  
 Bore Hole Diameter: 72 in. to 5 ft., and UNKNOWN in. to TD ft.  
 WELL WATER TO BE USED AS: 5 Public water supply 8 Air conditioning 11 Injection well  
 1 Domestic 3 Feedlot 6 Oil field water supply 9 Dewatering 12 Other (Specify below)  
 2 Irrigation 4 Industrial 7 Lawn and garden only 10 Monitoring well PLUG  
 Was a chemical/bacteriological sample submitted to Department? Yes --- No X; If yes, mo/day/yr sample was submitted ---  
 Water Well Disinfected? Yes X No ---

5 TYPE OF BLANK CASING USED: 5 Wrought iron 8 Concrete tile CASING JOINTS: Glued --- Clamped ---  
 1 Steel 3 RMP (SR) 6 Asbestos-Cement 9 Other (specify below) LIME STONE ROCKS Welded ---  
 2 PVC 4 ABS 7 Fiberglass Threaded ---

Blank casing diameter 72 in. to 18 ft., Dia. UNKNOWN in. to TD ft., Dia. --- in. to --- ft.  
 Casing height above land surface --- in., weight NA lbs./ft. Wall thickness or gauge No. ---

TYPE OF SCREEN OR PERFORATION MATERIAL: 7 PVC 10 Asbestos-cement  
 1 Steel 3 Stainless steel 5 Fiberglass 8 RMP (SR) 11 Other (specify) LIME STONE ROCKS  
 2 Brass 4 Galvanized steel 6 Concrete tile 9 ABS 12 None used (open hole)

SCREEN OR PERFORATION OPENINGS ARE: 5 Gauzed wrapped 8 Saw cut 11 None (open hole)  
 1 Continuous slot 3 Mill slot 6 Wire wrapped 9 Drilled holes  
 2 Louvered shutter 4 Key punched 7 Torch cut 10 Other (specify) LIME STONE ROCKS

SCREEN-PERFORATED INTERVALS: From 6L ft. to TD ft., From --- ft. to --- ft., From --- ft. to --- ft.  
 GRAVEL PACK INTERVALS: From NA ft. to --- ft., From --- ft. to --- ft., From --- ft. to --- ft.

6 GROUT MATERIAL: 1 Neat cement 2 Cement grout 3 Bentonite 4 Other ---  
 Grout Intervals: From 4.5 ft. to 5 ft., From --- ft. to --- ft., From --- ft. to --- ft.

What is the nearest source of possible contamination:  
 1 Septic tank 4 Lateral lines 7 Pit privy 10 Livestock pens 14 Abandoned water well  
 2 Sewer lines 5 Cess pool 8 Sewage lagoon 11 Fuel storage 15 Oil well/Gas well  
 3 Watertight sewer lines 6 Seepage pit 9 Feedyard 12 Fertilizer storage 16 Other (specify below)  
 13 Insecticide storage WELL & CISTERN  
 Direction from well? EAST How many feet? 20-25

FROM	TO	LITHOLOGIC LOG	FROM	TO	PLUGGING INTERVALS
		<u>HAND DUG - NO RECORDS -</u>	<u>1.5</u>	<u>4.5</u>	<u>6L - CLAY BASE FILL</u>
			<u>4.5</u>	<u>5</u>	<u>BENTONITE</u>
			<u>5</u>	<u>17</u>	<u>ROCK AND CLAY FILL</u>
			<u>17</u>	<u>2S</u>	<u>SAND</u>
			<u>25</u>	<u>TD</u>	<u>SILT</u>
				<u>TD</u>	<u>UNKNOWN</u>
					<u>PROBED TO 28'</u>

7 CONTRACTOR'S OR LANDOWNER'S CERTIFICATION: This water well was (1) constructed, (2) reconstructed, or (3) plugged under my jurisdiction and was completed on (mo/day/year) 06-11-93 and this record is true to the best of my knowledge and belief. Kansas Water Well Contractor's License No. 479 This Water Well Record was completed on (mo/day/yr) 06-14-93 under the business name of EBBERTS DRILLING by (signature) [Signature]