


WATER WELL RECORD Form WWC-5 KSA 82a-1212

1 LOCATION OF WATER WELL: County: LYON Fraction: NW 1/4 NW 1/4 NW 1/4 Section Number: 24 Township Number: T 19 S Range Number: R 11 EW

Distance and direction from nearest town or city street address of well if located within city?
FROM EMPORIA - 1 1/2 M E ON LOGAN AVE FROM HW 99 S

2 WATER WELL OWNER: GREGG-ANDREWEN EYESTONE
 RR#, St. Address, Box #: ROUTE 1 BOX 11C Board of Agriculture, Division of Water Resources
 City, State, ZIP Code: EMPORIA KS 66801 Application Number:

3 LOCATE WELL'S LOCATION WITH AN "X" IN SECTION BOX:

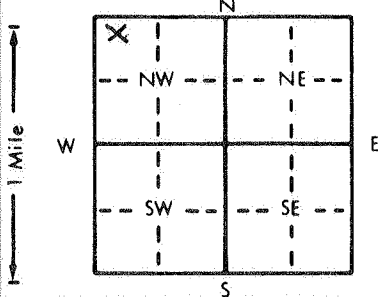

4 DEPTH OF COMPLETED WELL: 51 ft. ELEVATION: -
 Depth(s) Groundwater Encountered: *UNKNOWN ft. 2. - ft. 3. - ft.

WELL'S STATIC WATER LEVEL: 3.0 ft. below land surface measured on mo/day/yr 08-16-91
 Pump test data: Well water was NA ft. after - hours pumping - gpm
 Est. Yield NA gpm: Well water was - ft. after - hours pumping - gpm
 Bore Hole Diameter: *UNKNOWN ft. and - in. to - ft.

WELL WATER TO BE USED AS:
 1 Domestic - 3 Feedlot - 6 Oil field water supply - 9 Dewatering - 12 Other (Specify below)
 2 Irrigation - 4 Industrial - 7 Lawn and garden only - 10 Monitoring well -
 5 Public water supply - 8 Air conditioning - 11 Injection well -
 Was a chemical/bacteriological sample submitted to Department? Yes - No X; If yes, mo/day/yr sample was submitted -
 Water Well Disinfected? Yes X No -

5 TYPE OF BLANK CASING USED:
 1 Steel - 3 RMP (SR) - 6 Asbestos-Cement - 9 Other (specify below) *A FORM OF PVC
 2 PVC - 4 ABS - 7 Fiberglass - 10 Asbestos-cement -
 Blank casing diameter: *5.10 in. to - ft., Dia. - in. to - ft., Dia. - in. to - ft.
 Casing height above land surface: *40 in., weight SCH 40 lbs./ft. Wall thickness or gauge No. -


TYPE OF SCREEN OR PERFORATION MATERIAL: UNKNOWN
 1 Steel - 3 Stainless steel - 5 Fiberglass - 8 RMP (SR) - 11 Other (specify) -
 2 Brass - 4 Galvanized steel - 6 Concrete tile - 9 ABS - 12 None used (open hole) -

SCREEN OR PERFORATION OPENINGS ARE: UNKNOWN
 1 Continuous slot - 3 Mill slot - 6 Wire wrapped - 9 Drilled holes - 11 None (open hole)
 2 Louvered shutter - 4 Key punched - 7 Torch cut - 10 Other (specify) -

SCREEN-PERFORATED INTERVALS: From UNKNOWN ft. to - ft., From - ft. to - ft., From - ft. to - ft.
 GRAVEL PACK INTERVALS: From UNKNOWN ft. to - ft., From - ft. to - ft., From - ft. to - ft.

6 GROUT MATERIAL: *1 Neat cement 2 Cement grout 3 Bentonite 4 Other -
 Grout Intervals: From #3 2 ft. to 3.5 ft., From #1 3.5 ft. to UNKNOWN ft., From - ft. to - ft.

What is the nearest source of possible contamination:
 1 Septic tank - 4 Lateral lines - 7 Pit privy - 10 Livestock pens - 14 Abandoned water well -
 2 Sewer lines - 5 Cess pool - 8 Sewage lagoon - 11 Fuel storage - 15 Oil well/Gas well -
 3 Watertight sewer lines - 6 Seepage pit - 9 Feedyard - 12 Fertilizer storage - 16 Other (specify below) -
 13 Insecticide storage -
 Direction from well? E How many feet? 60-70 DOWNSLOPE

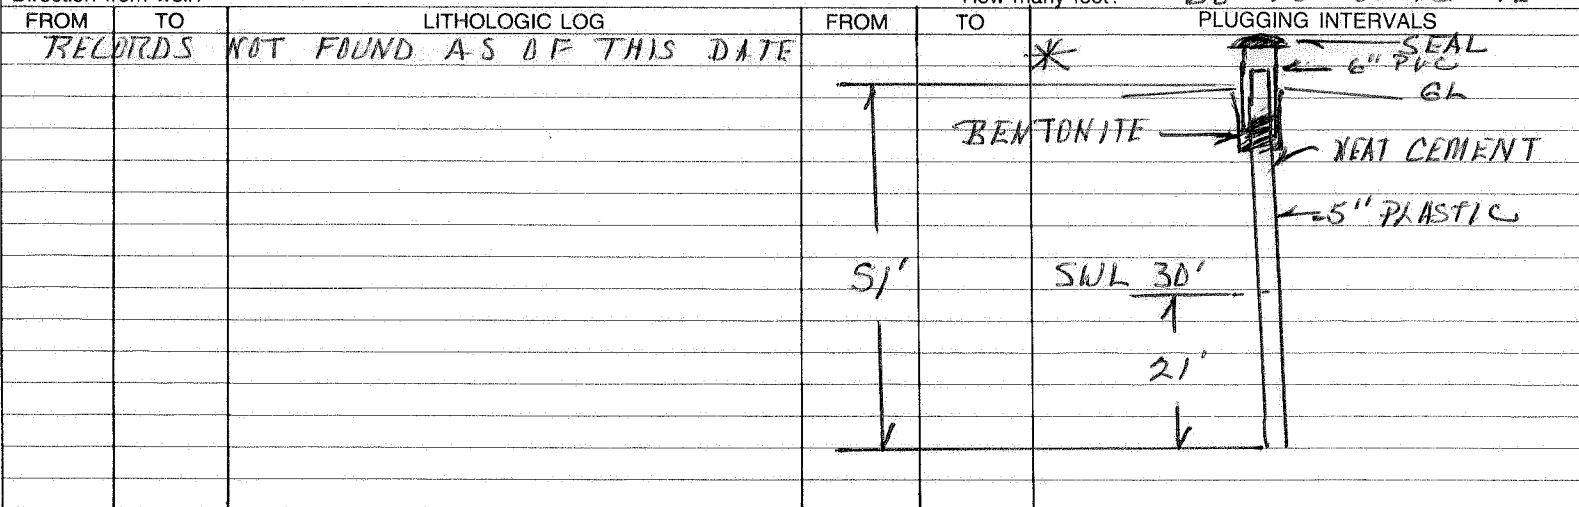

7 CONTRACTOR'S OR LANDOWNER'S CERTIFICATION: This water well was (1) constructed, (2) reconstructed, or (3) plugged under my jurisdiction and was completed on (mo/day/year) 08-16-91 and this record is true to the best of my knowledge and belief. Kansas Water Well Contractor's License No. 479 This Water Well Record was completed on (mo/day/yr) 08-23-91 under the business name of EBBERTS DRILLING by (signature) Morgan Ebberts

INSTRUCTIONS: Use typewriter or ball point pen. PLEASE PRESS FIRMLY and PRINT clearly. Please fill in blanks, underline or circle the correct answers. Send top three copies to Kansas Department of Health and Environment, Bureau of Water, Topeka, Kansas 66620-7320. Telephone: 913-296-5545. Send one to WATER WELL OWNER and retain one for your records.