


1 LOCATION OF WATER WELL: Fraction Section Number Township Number Range Number
 County: LYON NE $\frac{1}{4}$ $\frac{1}{4}$ 16 19 11 5 E/W

Distance and direction from nearest town or city street address of well if located within city?

407 Cottonwood Emporia KS

2 WATER WELL OWNER: GARY LONGCOR
 RR #, St. Address, Box #: 402 Cottonwood Board of Agriculture, Division of Water Resources
 City, State, ZIP Code: EMPORIA KS Application Number: _____

3 MARK WELL'S LOCATION WITH AN "X" IN SECTION BOX:

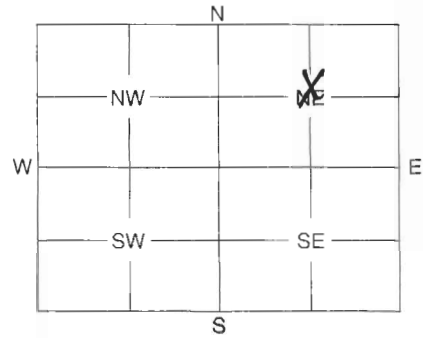

4 DEPTH OF WELL 22 ft.

WELL'S STATIC WATER LEVEL 0 ft.

WELL WAS USED AS:

- | | | |
|--|----------------------------|--------------------|
| <input checked="" type="checkbox"/> 1 Domestic | 5 Public Water Supply | 9 Dewatering |
| 2 Irrigation | 6 Oil Field Water Supply | 10 Monitoring Well |
| 3 Feedlot | 7 Domestic (Lawn & Garden) | 11 Injection Well |
| 4 Industrial | 8 Air Conditioning | 12 Other |

Was a chemical / bacteriological sample submitted to Department? Yes No
 If yes, mo/day/yr sample was submitted

Water Well Disinfected: Yes No

5 TYPE OF BLANK CASING USED:

- | | | | | |
|---------|------------|-------------------|-----------------|-------------------------|
| 1 Steel | 3 RMP (SR) | 5 Wrought | 7 Fiberglass | 9 Other (Specify below) |
| 2 PVC | 4 ABS | 6 Asbestos-Cement | 8 Concrete Tile | <u>land up rock</u> |

Blank casing diameter 4.8 in. Was casing pulled? Yes No If yes, how much 5 ft.
 Casing height above or below land surface even ground

6 GROUT PLUG MATERIAL: 1 Neat cement 2 Cement grout 3 Bentonite 4 Other

Grout Plug Intervals: From 5 ft. to 4.5 ft., From ft. to ft., From to ft.

What is the nearest source of possible contamination:

- | | | | |
|--|-------------------|-------------------------|--------------------------|
| 1 Septic tank | 6 Seepage pit | 11 Fuel storage | 16 Other (specify below) |
| 2 Sewer lines | 7 Pit privy | 12 Fertilizer storage | <u>no known source</u> |
| <input checked="" type="checkbox"/> 3 Watertight sewer lines | 8 Sewage lagoon | 13 Insecticide storage | <u>Source</u> |
| 4 Lateral lines | 9 Feedyard | 14 Abandoned water well | |
| 5 Cess pool | 10 Livestock pens | 15 Oil well/Gas well | |

Direction from well? How many feet?

FROM	TO	PLUGGING MATERIALS
<u>22</u>	<u>0.7</u>	<u>Rock from Top of Well</u>
<u>7.0</u>	<u>10.5</u>	<u>CLAY</u>
<u>5.0</u>	<u>4.5</u>	<u>Bentonite</u>
<u>4.5</u>	<u>0</u>	<u>BK dirt rounded to allow for settlement</u>

located in rear yard approx middle west of house 40 ft.

7 CONTRACTOR'S OF LANDOWNER'S CERTIFICATION: This water well was plugged under my jurisdiction and was completed on (mo/day/year) 7-14-07 and this record is true to the best of my knowledge and belief. Kansas Water Well Contractor's License No. This Water Well Record was completed on (mo/day/year) under the business name of Dayla L. Browning / Crowdd Const. (7-14-07) by (signature)

INSTRUCTIONS: Use typewriter or ball point pen. Please press firmly and print clearly. Please fill in blanks, underline or circle the correct answers. Send top three copies to Kansas Department of Health and Environment, Bureau of Water, Geology Section, 1000 SW Jackson St., Ste. 420, Topeka, Kansas 66612-1367. Telephone: 785/296-5522. Send one to Water Well Owner and retain one for your records.