

CORRECTION(S) TO WATER WELL RECORD (WWC-5)  
(to rectify lacking or incorrect information)

County: Lyon

Location listed as:

Location changed to:

Section-Township-Range: 20-195-11E

20-195-11E

Fraction ( 1/4 1/4 1/4): None Given

NW NE NE NE

Other changes: Initial statements: No written description.

Changed to: ~200 yds. W. of intersection of Prairie St. & Road 160, Emporia, KS, S. into.

Comments: \_\_\_\_\_

verification method: Phone call to well contractor, area road map, and mapping tool & aerial photo on KGS website.


initials: DR date: 12/19/2008

submitted by: Kansas Geological Survey, Data Resources Library, 1930 Constant Ave., Lawrence, KS 66047-3726  
to: Kansas Dept of Health & Environment, Bureau of Water, 1000 SW Jackson, Suite 420, Topeka, KS 66612-1367.

1 LOCATION OF WATER WELL:	Fraction ¼    ¼    ¼	Section Number 20	Township Number 19    S	Range Number 11    E    E/W
---------------------------	-------------------------	----------------------	----------------------------	--------------------------------

Distance and direction from nearest town or city street address of well if located within city?

2 WATER WELL OWNER: **WESTAR ENERGY**  
 818 S. KANSAS AVE  
 RR #, St. Address, Box #: **TOPEKA, KS 66612**  
 City, State, ZIP Code :  
 Board of Agriculture, Division of Water Resources  
 Application Number:

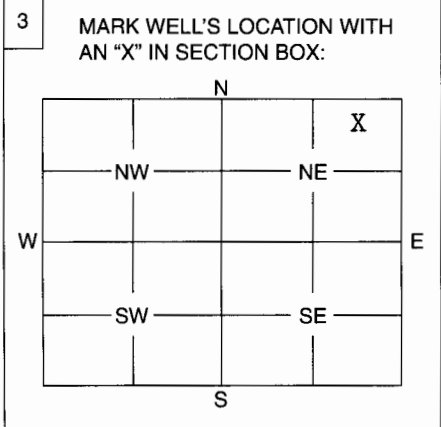

4 DEPTH OF WELL ..... 39.5 ..... ft.  
 WELL'S STATIC WATER LEVEL ..... 12.5 ..... ft.  
 WELL WAS USED AS:

1 Domestic	5 Public Water Supply	9 Dewatering
2 Irrigation	6 Oil Field Water Supply	10 Monitoring Well
3 Feedlot	7 Domestic (Lawn & Garden)	11 Injection Well
4 Industrial	8 Air Conditioning	12 Other .....

Was a chemical / bacteriological sample submitted to Department? Yes ..... No .....  
 If yes, mo/day/yr sample was submitted .....

Water Well Disinfected: Yes ..... No .....

5 TYPE OF BLANK CASING USED:

1 Steel	3 RMP (SR)	5 Wrought	7 Fiberglass	9 Other (Specify below)
2 PVC	4 ABS	6 Asbestos-Cement	8 Concrete Tile	

Blank casing diameter ..... 6 ..... in.      Was casing pulled?    Yes     No .....      If yes, how much ..... 18" .....  
 Casing height above or below land surface ..... 18" ..... in.

6 GROUT PLUG MATERIAL:    1 Neat cement    2 Cement grout    3 Bentonite    4 Other ..... DIRT .....

Grout Plug Intervals: (2) From 39.5 ft. to 1.5 ft. (4) From 1.5 ft. to 0 ft., From ..... to ..... ft.

What is the nearest source of possible contamination:

1 Septic tank	6 Seepage pit	11 Fuel storage	( 16) Other (specify below)
2 Sewer lines	7 Pit privy	12 Fertilizer storage	<u>TRANSFORMER</u>
3 Watertight sewer lines	8 Sewage lagoon	13 Insecticide storage	
4 Lateral lines	9 Feedyard	14 Abandoned water well	
5 Cess pool	10 Livestock pens	15 Oil well/Gas well	

Direction from well? ..... NW .....      How many feet? ..... 20 .....

FROM	TO	PLUGGING MATERIALS
0	1.5	DIRT
1.5	39.5	CEMENT GROUT

7 CONTRACTOR'S OF LANDOWNER'S CERTIFICATION: This water well was plugged under my jurisdiction and was completed on (mo/day/year) ..... 11/25/2008 ..... and this record is true to the best of my knowledge and belief. Kansas Water Well Contractor's License No. .... This Water Well Record was completed on (mo/day/year) ..... under the business name of ..... WOLF CONSTRUCTION COMPANY ..... by (signature)

INSTRUCTIONS: Use typewriter or ball point pen. Please press firmly and print clearly. Please fill in blanks, underline or circle the correct answers. Send top three copies to Kansas Department of Health and Environment, Bureau of Water, Geology Section, 1000 SW Jackson St., Ste. 420, Topeka, Kansas 66612-1367. Telephone: 785/296-5522. Send one to Water Well Owner and retain one for your records.