


<b>1 LOCATION OF WATER WELL:</b> County: Lyon	Fraction SE ¼ SE ¼ NW ¼	Section Number 11	Township Number 19S	Range Number 11E
--------------------------------------------------	----------------------------	----------------------	------------------------	---------------------

Distance and direction from nearest town or city street address of well if located within city?  
1202 E. 12<sup>th</sup>, Emporia, KS

<b>2 WATER WELL OWNER:</b> KDHE Time and Materials for M&B Petroleum RR#, St. Address, Box #: 1000 SW Jackson #410  City, State, ZIP Code: Topeka, KS 66612	Global Positioning System (decimal degrees, min. of 4 digits) Latitude: _____ Longitude: _____ Elevation: _____ Datum: _____ Data Collection Method: _____
---	---

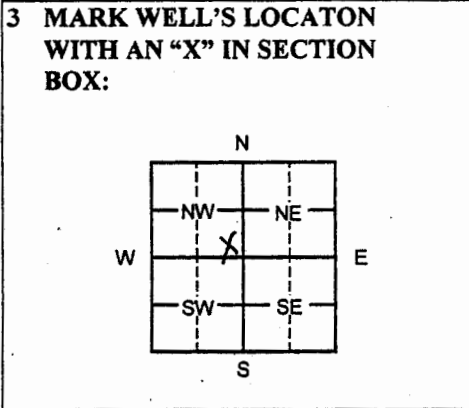

**4 DEPTH OF WELL** 19.5 ft.  
MW8  
WELL'S STATIC WATER LEVEL \_\_\_\_\_ ft.  
WELL WAS USED AS:

1 Domestic	5 Public Water Supply	9 Dewatering
2 Irrigation	6 Oil Field Water Supply	10 Monitoring
3 Feedlot	7 Domestic (Lawn & Garden)	11 Injection Well
4 Industrial	8 Air Conditioning	12 Other _____

Was a chemical/bacteriological sample submitted to Department? Yes \_\_\_ No X

**5 TYPE OF BLANK CASING USED:**

1 Steel	3 RMP (SR)	5 Wrought	7 Fiberglass	9 Other (specify below) _____
<u>2</u> PVC	4 ABS	6 Asbestos-Cement	8 Concrete Tile	

Blank casing diameter 2 in. Was casing pulled? Yes X No \_\_\_ If yes, how much 3 feet  
Casing height above or below land surface \_\_\_\_\_ in.

**6 GROUT PLUG MATERIAL:** 1 Neat cement 2 Cement grout 3 Bentonite 4 Other Soil: 0-3 feet

Grout Plug Intervals: From 3 ft. to 19.5 ft., From \_\_\_\_\_ ft. to \_\_\_\_\_ ft., From \_\_\_\_\_ ft. to \_\_\_\_\_ ft.

- What is the nearest source of possible contamination:
- |                          |                   |                         |                                |
|--------------------------|-------------------|-------------------------|--------------------------------|
| 1 Septic tank            | 6 Seepage pit     | 11 Fuel storage         | 16 Other (specify below) _____ |
| 2 Sewer lines            | 7 Pit privy       | 12 Fertilizer storage   |                                |
| 3 Watertight sewer lines | 8 Sewage lagoon   | 13 Insecticide storage  |                                |
| 4 Lateral lines          | 9 Feedyard        | 14 Abandoned water well | Direction from well? _____     |
| 5 Cess pool              | 10 Livestock pens | 15 Oil well/Gas well    | How many feet? _____           |

FROM	TO	PLUGGING MATERIALS	FROM	TO	PLUGGING MATERIALS
0	3	Soil			
3	19.5	Bentonite			

**7 CONTRACTOR'S OR LANDOWNER'S CERTIFICATION:** This water well was plugged under my jurisdiction and was completed on (mo/day/year) 12/19/08 and this record is true to the best of my knowledge and belief. Kansas Water Well Contractor's License No. 757. This Water Well Record was completed on (mo/day/year) 12/22/08 under the business name of Larsen and Associates, Inc. by (signature)

**INSTRUCTIONS:** Please fill in blanks or circle the correct answers. Send top three copies to Kansas Department of Health and Environment, Bureau of Water, Geology Section, 1000 SW Jackson St., Ste. 420, Topeka, Kansas 66612-1367. Telephone: 785/296-5522. Send one to Water Well Owner and retain one for your records. Visit us at <http://www.kdheks.gov/waterwell>.