


| | | | | |
|---|-----------------------------------|-----------------------------|-------------------------------|----------------------------|
| 1 LOCATION OF WATER WELL: County: <u>Lyon</u> | Fraction <u>NE ¼ NE ¼ NE ¼</u> | Section Number <u>16</u> | Township Number <u>19S</u> | Range Number <u>11E</u> |
|---|-----------------------------------|-----------------------------|-------------------------------|----------------------------|

Distance and direction from nearest town or city street address of well if located within city?
701 W. 6th, Emporia, KS

| | |
|--|--|
| 2 WATER WELL OWNER: Sunset Equities, Inc. (Wendy's) RR#, St. Address, Box #: <u>1321 E. 1st, PO Box 1283</u> City, State, ZIP Code: <u>McPherson, KS 67460</u> | Global Positioning System (decimal degrees, min. of 4 digits) Latitude: _____ Longitude: _____ Elevation: _____ Datum: _____ Data Collection Method: _____ |
|--|--|

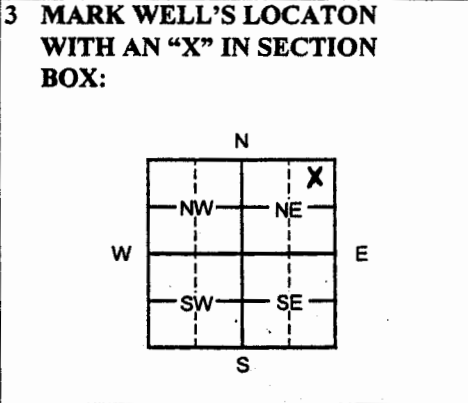

4 DEPTH OF WELL 29 ft. **MW1**

WELL'S STATIC WATER LEVEL _____ ft.

WELL WAS USED AS:

| | | |
|--------------|----------------------------|---|
| 1 Domestic | 5 Public Water Supply | 9 Dewatering |
| 2 Irrigation | 6 Oil Field Water Supply | <input checked="" type="checkbox"/> 10 Monitoring |
| 3 Feedlot | 7 Domestic (Lawn & Garden) | 11 Injection Well |
| 4 Industrial | 8 Air Conditioning | 12 Other _____ |

Was a chemical/bacteriological sample submitted to Department? Yes ___ No

5 TYPE OF BLANK CASING USED:

| | | | | |
|---|------------|-------------------|-----------------|-------------------------|
| 1 Steel | 3 RMP (SR) | 5 Wrought | 7 Fiberglass | 9 Other (specify below) |
| <input checked="" type="checkbox"/> 2 PVC | 4 ABS | 6 Asbestos-Cement | 8 Concrete Tile | _____ |

Blank casing diameter 2 in. Was casing pulled? Yes No ___ If yes, how much 3 ft.
 Casing height above or below land surface _____ in.

6 GROUT PLUG MATERIAL: 1 Neat cement 2 Cement grout 3 Bentonite 4 Other Soil: 0-3 ft.

Grout Plug Intervals: From 3 ft. to 29 ft., From _____ ft. to _____ ft., From _____ ft. to _____ ft.

What is the nearest source of possible contamination:

| | | | |
|--------------------------|-------------------|-------------------------|--------------------------|
| 1 Septic tank | 6 Seepage pit | 11 Fuel storage | 16 Other (specify below) |
| 2 Sewer lines | 7 Pit privy | 12 Fertilizer storage | _____ |
| 3 Watertight sewer lines | 8 Sewage lagoon | 13 Insecticide storage | _____ |
| 4 Lateral lines | 9 Feedyard | 14 Abandoned water well | Direction from well? |
| 5 Cess pool | 10 Livestock pens | 15 Oil well/Gas well | How many feet? |

| FROM | TO | PLUGGING MATERIALS | FROM | TO | PLUGGING MATERIALS |
|------|----|--------------------|------|----|--------------------|
| 0 | 3 | Soil | | | |
| 3 | 29 | Bentonite | | | |
| | | | | | |
| | | | | | |
| | | | | | |
| | | | | | |

7 CONTRACTOR'S OR LANDOWNER'S CERTIFICATION: This water well was plugged under my jurisdiction and was completed on (mo/day/year) 2/6/09 and this record is true to the best of my knowledge and belief. Kansas Water Well Contractor's License No. 757. This Water Well Record was completed on (mo/day/year) 3/30/09 under the business name of Larsen and Associates, Inc. by (signature)

INSTRUCTIONS: Please fill in blanks or circle the correct answers. Send top three copies to Kansas Department of Health and Environment, Bureau of Water, Geology Section, 1000 SW Jackson St., Ste. 420, Topeka, Kansas 66612-1367. Telephone: 785/296-5522. Send one to Water Well Owner and retain one for your records. Visit us at <http://www.kdheks.gov/waterwell>.