


1 LOCATION OF WATER WELL:	Fraction SE 4 1/4 1/4	Section Number 15	Township Number 19	Range Number 11 (E/W)
---------------------------	------------------------------	--------------------------	---------------------------	--

County: **LYON**
 Distance and direction from nearest town or city street address of well if located within city?

103 S. EXCHANGE

2 WATER WELL OWNER:	RR #, St. Address, Box #: 103 S. EXCHANGE City, State, ZIP Code: EMPORIA, KS. 66801	Board of Agriculture, Division of Water Resources Application Number:
---------------------	--	--

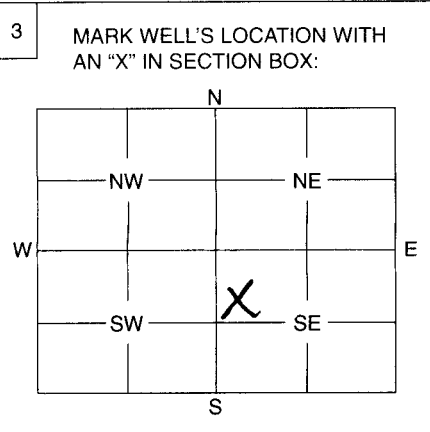

4 DEPTH OF WELL 35 ft.	WELL'S STATIC WATER LEVEL 15 ft.
WELL WAS USED AS:	
<input checked="" type="radio"/> 1 Domestic <input type="radio"/> 2 Irrigation <input type="radio"/> 3 Feedlot <input type="radio"/> 4 Industrial	<input type="radio"/> 5 Public Water Supply <input type="radio"/> 6 Oil Field Water Supply <input type="radio"/> 7 Domestic (Lawn & Garden) <input type="radio"/> 8 Air Conditioning
<input type="radio"/> 9 Dewatering <input type="radio"/> 10 Monitoring Well <input type="radio"/> 11 Injection Well <input type="radio"/> 12 Other	
Was a chemical / bacteriological sample submitted to Department? Yes No <input checked="" type="checkbox"/> If yes, mo/day/yr sample was submitted	
Water Well Disinfected: Yes <input checked="" type="checkbox"/> No	

5 TYPE OF BLANK CASING USED:

<input checked="" type="radio"/> 1 Steel	<input type="radio"/> 3 RMP (SR)	<input type="radio"/> 5 Wrought	<input type="radio"/> 7 Fiberglass	<input type="radio"/> 9 Other (Specify below)
<input type="radio"/> 2 PVC	<input type="radio"/> 4 ABS	<input type="radio"/> 6 Asbestos-Cement	<input type="radio"/> 8 Concrete Tile	

Blank casing diameter **6** in. Was casing pulled? Yes No If yes, how much **10'**
 Casing height above or below land surface **BELOW** **12"** in.

6 GROUT PLUG MATERIAL: 1 Neat cement 2 Cement grout 3 Bentonite 4 Other

Grout Plug Intervals: From **3** ft. to **6** ft., From ft. to ft., From to ft.

What is the nearest source of possible contamination:

<input checked="" type="radio"/> 1 Septic tank	<input type="radio"/> 6 Seepage pit	<input type="radio"/> 11 Fuel storage	<input type="radio"/> 16 Other (specify below)
<input checked="" type="radio"/> 2 Sewer lines	<input type="radio"/> 7 Pit privy	<input type="radio"/> 12 Fertilizer storage	
<input type="radio"/> 3 Watertight sewer lines	<input type="radio"/> 8 Sewage lagoon	<input type="radio"/> 13 Insecticide storage	
<input type="radio"/> 4 Lateral lines	<input type="radio"/> 9 Feedyard	<input type="radio"/> 14 Abandoned water well	
<input type="radio"/> 5 Cess pool	<input type="radio"/> 10 Livestock pens	<input type="radio"/> 15 Oil well/Gas well	

Direction from well? **NORTH** How many feet? **APPROX. 30 FT.**

FROM	TO	PLUGGING MATERIALS
0	3'	TOP SOIL
3'	6'	BENTONITE
6'	20'	CLAY MATERIAL
20'	35'	CRUSHED ROCK

7 CONTRACTOR'S OF LANDOWNER'S CERTIFICATION: This water well was plugged under my jurisdiction and was completed on (mo/day/year) **12/14/01** and this record is true to the best of my knowledge and belief. Kansas Water Well Contractor's License No. This Water Well Record was completed on (mo/day/year) under the business name of **HOGAN EXCAVATING** by (signature) **[Signature]** **[Signature]**

INSTRUCTIONS: Use typewriter or ball point pen. Please press firmly and print clearly. Please fill in blanks, underline or circle the correct answers. Send top three copies to Kansas Department of Health and Environment, Bureau of Water, Geology Section, 1000 SW Jackson St., Ste. 420, Topeka, Kansas 66612-1367. Telephone: 785/296-5522. Send one to Water Well Owner and retain one for your records.