


1 LOCATION OF WATER WELL: County: Lyon Fraction: SE 1/4 SE 1/4 SE 1/4 Section Number: 9 Township Number: T 19 S Range Number: R 11 E/W

Distance and direction from nearest town or city street address of well if located within city? 804 W. 6th Ave., Emporia

2 WATER WELL OWNER: KDHE RR#, St. Address, Box #: 1000 SW Jackson St., Suite 420 Topeka KS 66612 Board of Agriculture, Division of Water Resources Application Number:

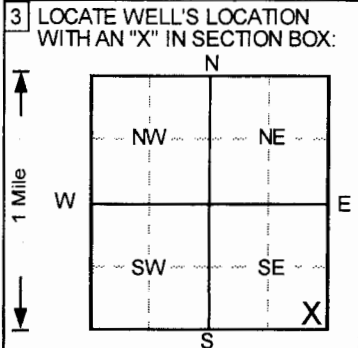

3 LOCATE WELL'S LOCATION WITH AN "X" IN SECTION BOX: 4 DEPTH OF COMPLETED WELL: 30 ft. ELEVATION: ... WELL'S STATIC WATER LEVEL: ... Pump test data: Well water was NA ft. after ... hours pumping ... gpm

5 TYPE OF BLANK CASING USED: 2 PVC 4 ABS 7 Fiberglass ... CASING JOINTS: Threaded. ... TYPE OF SCREEN OR PERFORATION MATERIAL: 7 PVC 10 Asbestos-cement ... SCREEN OR PERFORATION OPENINGS ARE: 3 Mill slot ... SCREEN-PERFORATED INTERVALS: From 26.5 ft to 30 ft ... GRAVEL PACK INTERVALS: From 25 ft to 30 ft

6 GROUT MATERIAL: 3 Bentonite 4 Other Concrete ... Grout Intervals: From 0 ft to 2 ft, From 2 ft to 25 ft ... What is the nearest source of possible contamination: 1 Septic tank, 4 Lateral lines, 7 Pit privy, 10 Livestock pens, 14 Abandoned water well

Table with columns: FROM, TO, LITHOLOGIC LOG, FROM, TO, PLUGGING INTERVALS. Rows include: 0-1 Gravel, compacted; 1-10 Clay, backfilled; 10-30 Sand, f-c, backfilled; CDW-4, Flushmount

7 CONTRACTOR'S OR LANDOWNER'S CERTIFICATION: This water well was (1) constructed, (2) reconstructed, or (3) plugged under my jurisdiction and was completed on (mo/day/year) 11/23/2010 ... Kansas Water Well Contractor's License No. 527 ... This Water Well Record was completed on (mo/day/yr) 12/16/2010 ... under the business name of GeoCore, Inc. by (signature) Dan Hill