


1 LOCATION OF WATER WELL: County: LYON Fraction: SW 1/4 NE 1/4 SE 1/4 Section Number: 1 Township Number: T 19 S Range Number: R 11 EW

Distance and direction from nearest town or city street address of well if located within city? APRX 1 MI N - 2 MI E OF EMPORIA (EIGHTH AVE FROM BODIN LAME RD)


2 WATER WELL OWNER: KEITH KELLUM
 RR#, St. Address, Box # 3300 - EIGHTH AVE Board of Agriculture, Division of Water Resource
 City, State, ZIP Code: EMPORIA KS 66801 Application Number:

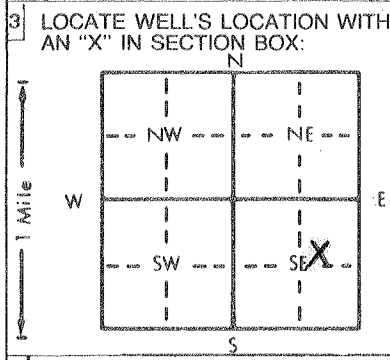

4 DEPTH OF COMPLETED WELL: 22 ft. ELEVATION:
 Depth(s) Groundwater Encountered: 1. UNKNOWN ft. 2. ft. 3. ft.
 WELL'S STATIC WATER LEVEL: 12 ft. below land surface measured on mo/day/yr 11-26-97
 Pump test data: Well water was NA ft. after hours pumping gpm
 Est. Yield: NA gpm: Well water was ft. after hours pumping gpm
 Bore Hole Diameter: UNKNOWN ft., and in. to ft.
 WELL WATER TO BE USED AS:
 1 Domestic 3 Feedlot 6 Oil field water supply 9 Dewatering 12 Other (Specify below)
 2 Irrigation 4 Industrial 7 Lawn and garden only 10 Monitoring well
 Was a chemical/bacteriological sample submitted to Department? Yes.....No X.....; If yes, mo/day/yr sample was submitted TESTED CLEAN IF BACT. - LYON CO H-DEP
 Water-Well Disinfected? Yes X No

5 TYPE OF BLANK CASING USED:
 1 Steel 3 RMP (SR) 6 Asbestos-Cement 9 Other (specify below) Welded
2 PVC 4 ABS 7 Fiberglass Threaded.....
 Blank casing diameter 5 in. to UNKNOWN ft., Dia in. to ft., Dia in. to ft.
 Casing height above land surface: 24 in., weight SCH. 40 lbs./ft. Wall thickness or gauge No.
 TYPE OF SCREEN OR PERFORATION MATERIAL:
 1 Steel 3 Stainless steel 5 Fiberglass 8 RMP (SR) 10 Asbestos-cement
 2 Brass 4 Galvanized steel 6 Concrete tile 9 ABS 11 Other (specify)
 12 None used (open hole)
 SCREEN OR PERFORATION OPENINGS ARE:
 1 Continuous slot 3 Mill slot 5 Gauzed wrapped 8 Saw cut 11 None (open hole)
 2 Louvered shutter 4 Key punched 6 Wire wrapped 9 Drilled holes
 7 Torch cut 10 Other (specify) UNKNOWN
 SCREEN-PERFORATED INTERVALS: From UNKNOWN ft. to ft., From ft. to ft.
 From ft. to ft., From ft. to ft.
 GRAVEL PACK INTERVALS: From UNKNOWN ft. to ft., From ft. to ft.
 From ft. to ft., From ft. to ft.

6 GROUT MATERIAL: 1 Neat cement 2 Cement grout 3 Bentonite 4 Other
 Grout Intervals: From ft. to ft., From ft. to ft., From ft. to ft.
 What is the nearest source of possible contamination:
 1 Septic tank 4 Lateral lines 7 Pit privy 10 Livestock pens 14 Abandoned water well
 2 Sewer lines 5 Cess pool 8 Sewage lagoon 11 Fuel storage 15 Oil well/Gas well
 3 Watertight sewer lines 6 Seepage pit 9 Feedyard 12 Fertilizer storage 16 Other (specify below)
 13 Insecticide storage
 Direction from well? NE How many feet? (8) 150 - (14) - 100

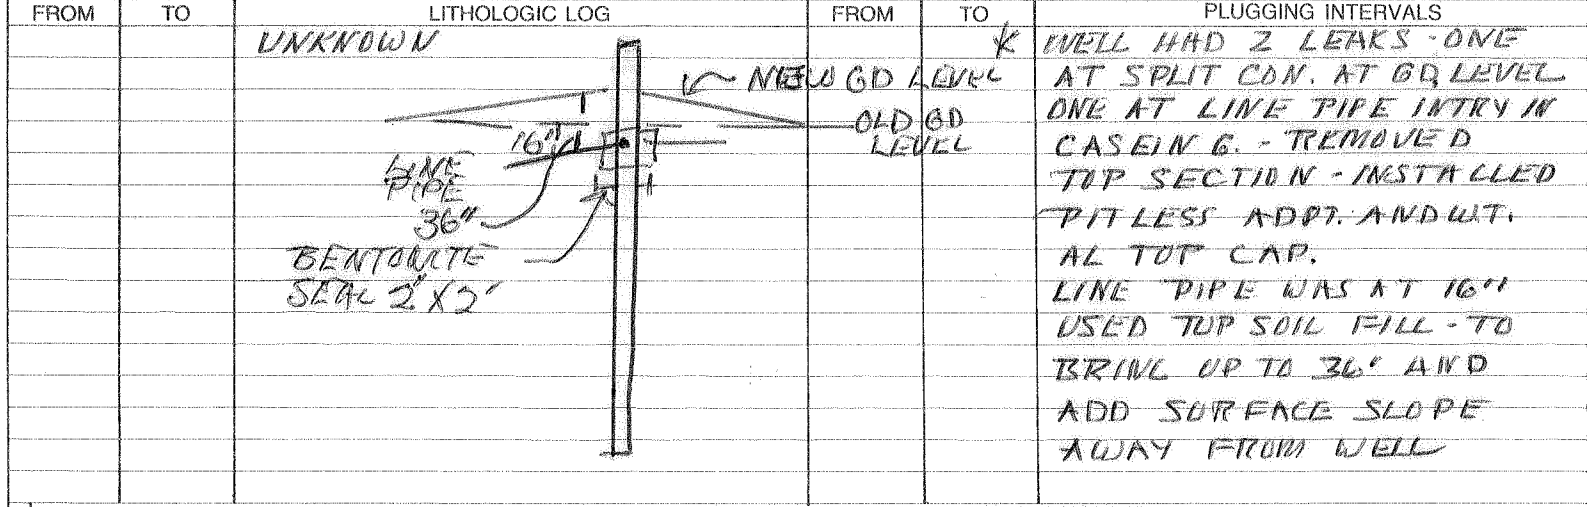

7 CONTRACTOR'S OR LANDOWNER'S CERTIFICATION: This water well was (1) constructed, (2) reconstructed or (3) plugged under my jurisdiction and was completed on (mo/day/year) 11-26-97 and this record is true to the best of my knowledge and belief. Kansas Water Well Contractor's License No. 479 This Water Well Record was completed on (mo/day/yr) 11-18-97 under the business name of EBBETTS DRILLING by (signature) [Signature]