

WATER WELL RECORD

Form WWC-5


Division of Water Resources App. No.

1 LOCATION OF WATER WELL: County: <u>Lyon</u>	Fraction <u>NW¼ NW¼ NE¼ SW¼</u>	Section Number <u>35</u>	Township No. <u>T 19 S</u>	Range Number <u>R 11</u> <input checked="" type="checkbox"/> E <input type="checkbox"/> W
---	------------------------------------	-----------------------------	-------------------------------	--

Street/Rural Address of Well Location; if unknown, distance & direction from nearest town or intersection: If at owner's address, check here .

Global Positioning System (GPS) information:
 Latitude: (in decimal degrees)
 Longitude: (in decimal degrees)
 Elevation:
 Datum: WGS 84, NAD 83, NAD 27
 Collection Method:
 GPS unit (Make/Model:)
 Digital Map/Photo, Topographic Map, Land Survey
 Est. Accuracy: <3 m, 3-5 m, 5-15 m, >15 m

2 WATER WELL OWNER: Scott Holland
 RR#, Street Address, Box #: 1115 Road 135
 City, State, ZIP Code : Emporia, Ks. 66801

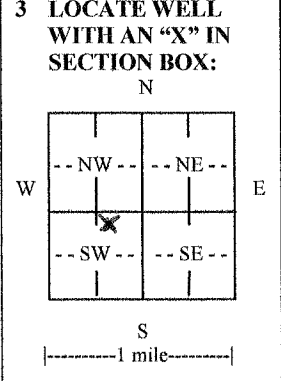

4 DEPTH OF COMPLETED WELL 200 ft. 4-200' bores

Depth(s) Groundwater Encountered (1). 160 ft. (2)..... ft. (3)..... ft.
 WELL'S STATIC WATER LEVEL.....ft. below land surface measured on mo/day/yr.....
 Pump test data: Well water was.....ft. after..... hours pumping..... gpm
 EST. YIELD...2...gpm. Well water was.....ft. after..... hours pumping..... gpm
 Bore Hole Diameter6.....in. to 200.....ft., andin. toft.
 WELL WATER TO BE USED AS: Public water supply Geothermal Injection well
 Domestic Feedlot Oil field water supply Dewatering Other (Specify below)
 Irrigation Industrial Domestic-lawn & garden Monitoring well Closed leaf
 Was a chemical/bacteriological sample submitted to Department? Yes No
 If yes, mo/day/yr sample was submitted.....
 Water well disinfected? Yes No

5 TYPE OF CASING USED: Steel PVC Other H.D. Polyethylene
 CASING JOINTS: Glued Clamped Welded Threaded Fusion
 Casing diameter 3/4 in. to 200 ft., Diameter in. to ft., Diameter in. to ft.
 Casing height ^{below} above land surface..... 36 in., Weight SDR11lbs./ft., Wall thickness or gauge No. 160 P.S.F.
 TYPE OF SCREEN OR PERFORATION MATERIAL: None Other (Specify)
 Steel Stainless Steel PVC
 Brass Galvanized Steel None used (open hole)
 SCREEN OR PERFORATION OPENINGS ARE: None
 Continuous slot Mill slot Gauze wrapped Torch cut Drilled holes None (open hole)
 Louvered shutter Key punched Wire wrapped Saw cut Other (specify)
 SCREEN-PERFORATED INTERVALS: From..... ft. to ft., From..... ft. to ft.
 From..... ft. to ft., From..... ft. to ft.
 GRAVEL PACK INTERVALS: From..... ft. to ft., From..... ft. to ft.
 From..... ft. to ft., From..... ft. to ft.

6 GROUT MATERIAL: Neat cement Cement grout Bentonite Other
 Grout Intervals: From 20.0 ft. to 3 ft., From..... ft. to ft., From..... ft. to ft.
 What is the nearest source of possible contamination:
 Septic tank Lateral lines Pit privy Livestock pens Insecticide storage Other (specify below)
 Sewer lines Cesspool Sewage lagoon Fuel storage Abandoned water well
 Watertight sewer lines Seepage pit Feedyard Fertilizer storage Oil well/gas well
 Direction from well North Distance from well 100'

FROM	TO	LITHOLOGIC LOG	FROM	TO	LITHO. LOG (cont.) or PLUGGING INTERVALS
0	14	Soil & clay			
14	19	Sandstone			
19	48	Shale			
48	54	lime	3	200	4-200' Bore Filled with High solids Bentonite
54	57	Shale			
57	60	lime			
60	75	Shale			
75	84	lime			
84	86	Shale			
86	89	lime			

7 CONTRACTOR'S OR LANDOWNER'S CERTIFICATION: This water well was constructed, reconstructed, or plugged under my jurisdiction and was completed on (mo/day/year) 11-28-12 and this record is true to the best of my knowledge and belief.
 Kansas Water Well Contractor's License No. 561..... This Water Well Record was completed on (mo/day/year) 11-29-12 under the business name of Evans Energy Des. Inc. by (signature) Scott Holland

INSTRUCTIONS: Use typewriter or ball point pen. PLEASE/PRESS FIRMLY and PRINT clearly. Please fill in blanks and check the correct answers. Send three copies (white, blue, pink) to Kansas Department of Health and Environment, Bureau of Water, Geology Section, 1000 SW Jackson St., Suite 420, Topeka, Kansas 666 12-1367. Telephone 785-296-5524. Send one copy to WATER WELL OWNER and retain one for your records. Include fee of \$5.00 for each constructed well. Visit us at <http://www.kdheks.gov/waterwell/index.html>.