


1 LOCATION OF WATER WELL: Fraction S1/4 SE 1/4 SE 1/4 1/4 Section Number 15 Township Number T 19 S Range Number 11 E W

Street/Rural Address of Well Location; if unknown, distance & direction from nearest town or intersection: If at owner's address, check here
517 S Cottonwood, Emporia 66801

2 WATER WELL OWNER: Property taken over by City of Emporia
 RR#, St. Address, Box #: 111 E 6th Ave, 66801
 City, State ZIP Code: Emporia, MO 66801

Global Positioning Systems (GPS) information:
 Latitude: _____ (in decimal degrees)
 Longitude: _____ (in decimal degrees)
 Elevation: _____
 Datum: WGS84, NAD83, NAD27
 Collection Method: _____
 GPS unit (Make/Model: _____)
 Digital Map/Photo, Topographic Map, Land Survey
 Est. Accuracy: < 3 m, 3-5 m, 5-15 m, > 15 m

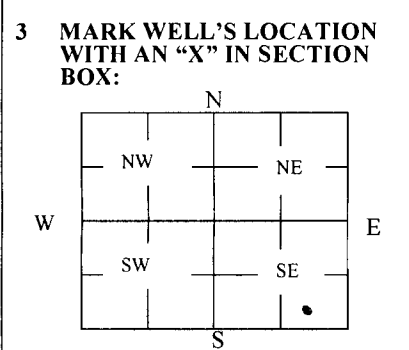

4 DEPTH OF WELL unknown ft. Was an improperly plugged well that soil had settled and created pit. No know records.

WELL'S STATIC WATER LEVEL unknown ft.

WELL WAS USED AS:

Domestic Public Water Supply Dewatering
 Irrigation Oil Field Water Supply Monitoring
 Feedlot Domestic (Lawn & Garden) Injection Well
 Industrial Air Conditioning Other _____

Was a chemical/bacteriological sample submitted to Department? Yes No

5 TYPE OF BLANK CASING USED:

Steel RMP (SR) Wrought Fiberglass Other (Specify below) HAND LAID ROCK
 PVC ABS Asbestos-Cement Concrete Tile

Blank casing diameter 48 in. Was casing pulled? Yes No If yes, how much Top 8'
 Casing height above or below land surface 96 in.

6 GROUT PLUG MATERIAL: Neat cement Cement grout Bentonite Other _____

Grout Plug Intervals: From 8 ft. to 7 ft., From 5 ft. to 4 ft., From 3 ft. to 2 ft.

What is the nearest source of possible contamination:

Septic tank Seepage pit Fuel storage Other (specify below) _____
 Sewer lines Pit privy Fertilizer storage _____
 Watertight sewer lines Sewage lagoon Insecticide storage _____
 Lateral lines Feedyard Abandoned water well Direction from well? SOUTH
 Cess pool Livestock pens Oil well/Gas well How many feet? 15'

| FROM | TO | PLUGGING MATERIALS | FROM | TO | PLUGGING MATERIALS |
|---------------|---------------|--------------------|------|----|--------------------|
| 8' | 7' | BENTONITE | 2 | 0 | CLAY |
| 5' | 4' | | | | |
| 3' | 2' | | | | |
| 7' | 5' | CLAY | | | |
| 5 | 4 | BENTONITE | | | |
| 4 | 3 | CLAY | | | |
| 3 | 2 | BENTONITE | | | |

7 CONTRACTOR'S OR LANDOWNER'S CERTIFICATION: This water well was plugged under my jurisdiction and was completed on (mo/day/year) 11-8-13 and this record is true to the best of my knowledge and belief. Kansas Water Well Contractor's License No. _____ This Water Well Record was completed on (mo/day/year) 11-8-13 under the business name of J.R. COFFMAN CONSTR, INC. by (signature) Jim R. Coffman - PRES.

INSTRUCTIONS: Use typewriter or ballpoint pen. Please press firmly and print clearly. Please fill in blanks, underline or circle the correct answers. Send top three copies to Kansas Department of Health and Environment, Bureau of Water, Geology Section, 1000 SW Jackson St., Ste. 420, Topeka, Kansas 66612-1367. Telephone: 785/296-5524. Send one to Water Well Owner and retain one for your records. Visit us at <http://www.kdheks.gov/waterwell/index.html>.

517 S Cottonwood, Emporia, KS

KS Section/Township/Range Finder



KDHE makes no assurances of the accuracy of information presented in the Section/Township/Range Finder. Provided as a public service by KS Department of Health and Environment. Tue Dec 3 2013 10:35:07 AM.

RECEIVED

DEC 10 2013

NO GEO SURVEY