

WATER WELL PLUGGING RECORD Form WWC-5P KSA 82a-1212 ID NO.

MW1


1 LOCATION OF WATER WELL: Fraction NW 1/4 NW 1/4 NW 1/4 SE 1/4 Section Number 10 Township Number T 19 S Range Number 11 X E W

Street/Rural Address of Well Location; if unknown, distance & direction from nearest town or intersection: If at owner's address, check here
1102 Commercial, Emporia, KS

Global Positioning Systems (GPS) information:
Latitude: NA (in decimal degrees)
Longitude: NA (in decimal degrees)
Elevation: NA

Horizontal Datum: [] WGS84, [] NAD83, [] NAD27
Collection Method: [] GPS unit (Make/model): [] Digital Map/Photo, [] Topographic Map, [] Land Survey
Est. Accuracy: [] <3 m, [] 3-5 m, [] 5-15 m, [] >15 m

2 WATER WELL OWNER: S & S Oil - Downtown
RR#, St. Address, Box #: 1102 Commercial
City, State ZIP Code: Emporia, KS 66801

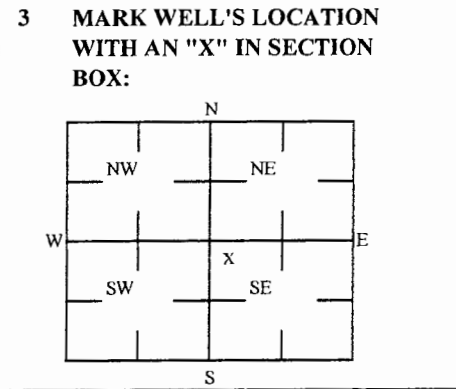

4 DEPTH OF WELL 37.49 ft. MW1
WELL'S STATIC WATER LEVEL NA ft
WELL WAS USED AS: [] Domestic, [] Irrigation, [] Feedlot, [] Industrial, [] Public Water Supply, [] Oil Field Water Supply, [] Domestic (Lawn & Garden), [] Air Conditioning, [] Dewatering, [X] Monitoring, [] Injection Well, [] Other
Was a chemical/bacteriological sample submitted to Department? Yes [] No [X]

5 TYPE OF BLANK CASING USED: [] Steel, [X] PVC, [] RMP (SR), [] ABS, [] Wrought, [] Asbestos-Cement, [] Fiberglass, [] Concrete Tile, [] Other (Specific below)
Blank casing diameter 2 in. Was casing pulled? Yes [X] No [] If yes, how much 3'
Casing height above or below land surface NA in.

6 GROUT PLUG MATERIAL: [] Neat cement, [] Cement grout, [X] Bentonite, [X] Other Soil and gravel: 0-0.5
Grout Plug Intervals: From 0.5 ft to 37.49 ft, From ft to ft, From ft to ft.
What is the nearest source of possible contamination: [] Septic tank, [] Sewer lines, [] Watertight sewer lines, [] Lateral lines, [] Cess pool, [] Seepage pit, [] Pit privy, [] Sewage lagoon, [] Feed yard, [] Livestock pens, [] Fuel storage, [] Fertilizer storage, [] Insecticide storage, [] Abandoned water well, [] Oil well/Gas well, [] Other (specify below)
Direction from well? How many feet?

Table with columns: FROM, TO, PLUGGING MATERIALS. Rows show 0 to 0.5 ft with Soil and gravel, and 0.5 to 37.49 ft with Bentonite.

7 CONTRACTOR'S OR LANDOWNER'S CERTIFICATION: This water well was plugged under my jurisdiction and was completed on (mo/day/year) 1/8/2018 and this record is true to the best of my knowledge and belief. Kansas Water Contractor's License No. 757. This Water Well Record was completed on (mo/day/year) 1/11/2018 under the business name of Larsen & Associates, Inc. By (signature)

Send one white copy to Kansas Department of Health & Environment, Geology Section, 1000 SW Jackson Street, Ste. 420, Topeka, KS 66612-1367. Visit us at http://www.kdheks.gov/waterwell/index.html Telephone 785-296-5524.