

-revised-

WATER WELL PLUGGING RECORD Form WWC-5P KSA 82a-1212 ID NO. MW7

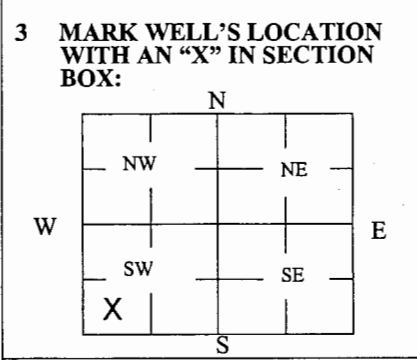
1 LOCATION OF WATER WELL: County: LYON	Fraction SE ¼ SE ¼ SW ¼ ¼	Section Number 10	Township Number T 19 S	Range Number 11 <input checked="" type="checkbox"/> E <input type="checkbox"/> W
--	------------------------------	----------------------	---------------------------	---

Street/Rural Address of Well Location; if unknown, distance & direction from nearest town or intersection: If at owner's address, check here

Global Positioning Systems (GPS) information:
 Latitude: 38.4058975 (in decimal degrees)
 Longitude: -96.1809922 (in decimal degrees)
 Elevation: _____
 Horizontal Datum: WGS84, NAD83, NAD27
 Collection Method: _____

2 WATER WELL OWNER: LARRY SCOTT
 RR#, St. Address, Box #:
 City, State ZIP Code:

GPS unit (Make/Model: _____)
 Digital Map/Photo, Topographic Map, Land Survey
 Est. Accuracy: < 3 m, 3-5 m, 5-15 m, > 15 m



4 DEPTH OF WELL 34.61 ft.
 WELL'S STATIC WATER LEVEL 32.96 ft

WELL WAS USED AS:

<input type="checkbox"/> Domestic	<input type="checkbox"/> Public Water Supply	<input type="checkbox"/> Dewatering
<input type="checkbox"/> Irrigation	<input type="checkbox"/> Oil Field Water Supply	<input checked="" type="checkbox"/> Monitoring
<input type="checkbox"/> Feedlot	<input type="checkbox"/> Domestic (Lawn & Garden)	<input type="checkbox"/> Injection Well
<input type="checkbox"/> Industrial	<input type="checkbox"/> Air Conditioning	<input type="checkbox"/> Other _____

Was a chemical/bacteriological sample submitted to Department? Yes No

5 TYPE OF BLANK CASING USED:

Steel RMP (SR) Wrought Fiberglass Other (Specify below) _____
 PVC ABS Asbestos-Cement Concrete Tile _____

Blank casing diameter 2 in. Was casing pulled? Yes No If yes, how much 3'
 Casing height above or below land surface 0 in.

6 GROUT PLUG MATERIAL: Neat cement Cement grout Bentonite Other Soil _____

Grout Plug Intervals: From 0 ft. to 0.5 ft., From 0.5 ft. to 3.5 ft., From 3.5 ft. to 34.61 ft.

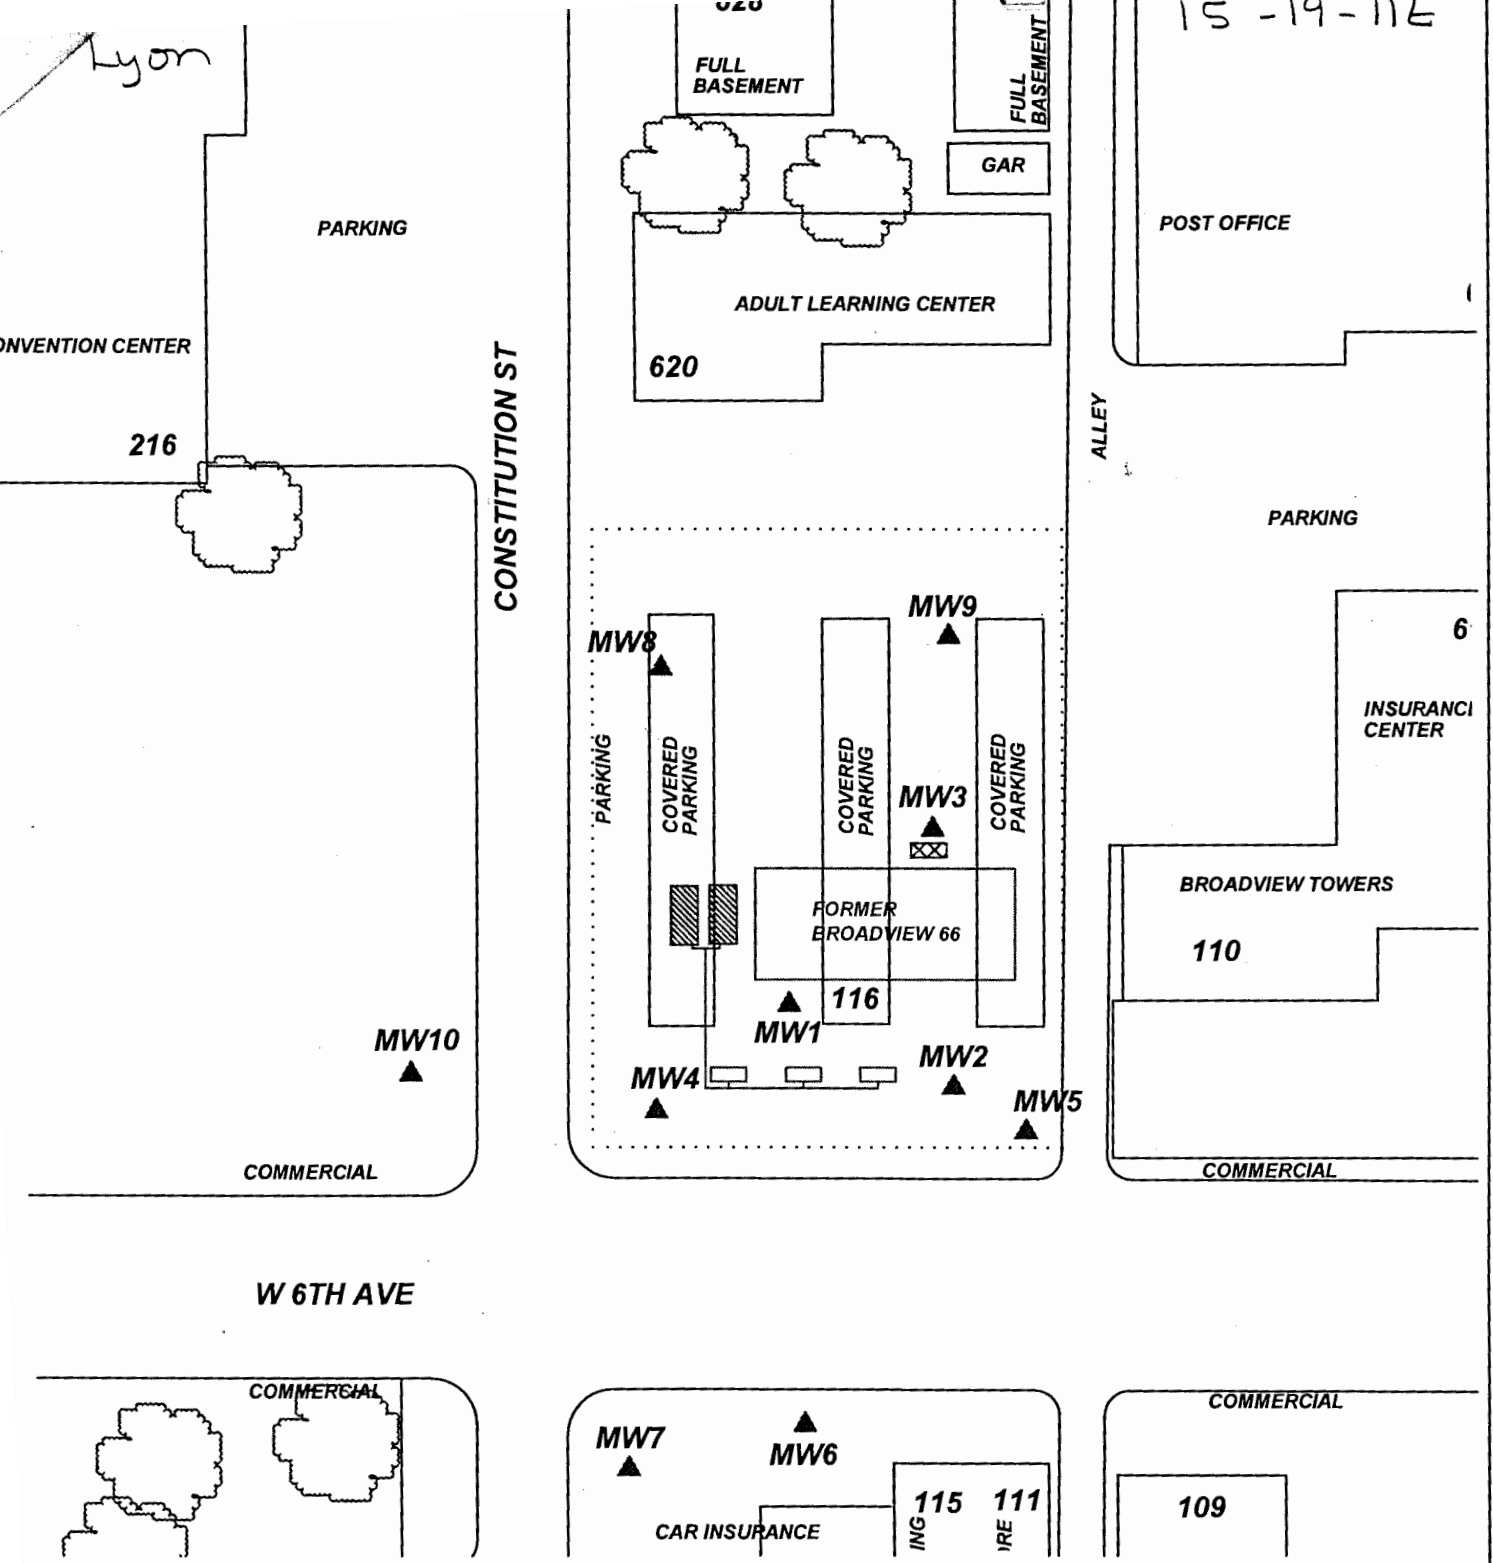
What is the nearest source of possible contamination:

<input type="checkbox"/> Septic tank	<input type="checkbox"/> Seepage pit	<input checked="" type="checkbox"/> Fuel storage	<input type="checkbox"/> Other (specify below) _____
<input type="checkbox"/> Sewer lines	<input type="checkbox"/> Pit privy	<input type="checkbox"/> Fertilizer storage	
<input type="checkbox"/> Watertight sewer lines	<input type="checkbox"/> Sewage lagoon	<input type="checkbox"/> Insecticide storage	
<input type="checkbox"/> Lateral lines	<input type="checkbox"/> Feedyard	<input type="checkbox"/> Abandoned water well	Direction from well? SOUTH
<input type="checkbox"/> Cess pool	<input type="checkbox"/> Livestock pens	<input type="checkbox"/> Oil well/Gas well	How many feet? 125


FROM	TO	PLUGGING MATERIALS	FROM	TO	PLUGGING MATERIALS
0	0.5	CONCRETE			
0.5	3.5	COMPACTED SOIL			
3.5	34.61	BENTONITE			


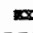



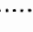
7 CONTRACTOR'S OR LANDOWNER'S CERTIFICATION: This water well was plugged under my jurisdiction and was completed on (mo/day/year) 3/15/18 and this record is true to the best of my knowledge and belief. Kansas Water Well Contractor's License No. 585. This Water Well Record was completed on (mo/day/year) 4/17/18 under the business name of ASSOCIATED ENVIRONMENTAL INC by (signature) _____

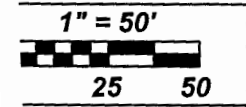
Send one white copy to Kansas Department of Health & Environment, Geology Section, 1000 SW Jackson Street, Ste. 420, Topeka, KS 66612-1367. Send one copy to WATER WELL OWNER and retain one for your records.
 Visit us at <http://www.kdheks.gov/waterwell/index.html> Telephone 785-296-5524.



TR: BROADVIEW 66
S: 116 W. 6TH
W: EMPORIA, KS
BY: B. STALNAKER DATE: 12/15/16
BY: B. STALNAKER DATE: 3/20/18
TF500 KDHE JOB # U3-056-12323

TITLE:

ASSOCIATED ENVIRONMENTAL INC.

LEGEND:
 = FORMER UST BASIN/EXCAVATION
 = FORMER WASTE OIL AST
 = FORMER PUMP ISLAND
 = MONITOR WELL
 = PLUGGED/DESTROYED WELL
 = SUBJECT PROPERTY



NOTES: