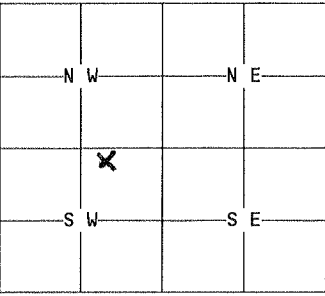


1	LOCATION OF WATER WELL:	Fraction	Section Number	Township Number	Range Number
	County: LYON	NW 1/4 NE 1/4 SW 1/4	8	19	11 E

Distance and direction from nearest town or city street address of well if located within city?
S-OF 12TH - W OF INDUSTRIAL - EMPORIA

2	WATER WELL OWNER: LEE E. NELSON - 1400 WIS - EMPORIA KS 66801 (BLUESTEM FARM + TRANCH)	Board of Agriculture, Division of Water Resources
	RR#, St. Address, Box #: 2611 W 50	Application Number:
	City, State, ZIP Code: EMPORIA KS 66801	

3	MARK WELL'S LOCATION WITH AN "X" IN SECTION BOX: N  S	4	DEPTH OF WELL *..... 32ft. WELL'S STATIC WATER LEVEL *..... -ft. WELL WAS USED AS: <table border="0"> <tr> <td>1 Domestic</td> <td>5 Public Water Supply</td> <td>9 Dewatering</td> </tr> <tr> <td>2 Irrigation</td> <td>6 Oil Field Water Supply</td> <td>10 Monitoring Well</td> </tr> <tr> <td>3 Feedlot</td> <td>7 Lawn and Garden Only</td> <td>11 Injection Well</td> </tr> <tr> <td>4 Industrial</td> <td>8 Air Conditioning</td> <td>12 Other.....</td> </tr> </table> <p>Was a chemical/bacteriological sample submitted to Department? Yes...No...X If yes, mo/day/yr sample was submitted..... Water Well Disinfected: Yes...X... No... Was a chemical/bacteriological sample submitted to Department? Yes.
1 Domestic	5 Public Water Supply	9 Dewatering													
2 Irrigation	6 Oil Field Water Supply	10 Monitoring Well													
3 Feedlot	7 Lawn and Garden Only	11 Injection Well													
4 Industrial	8 Air Conditioning	12 Other.....													

5	TYPE OF BLANK CASING USED: <table border="0"> <tr> <td>1 Steel</td> <td>3 RMP (SR)</td> <td>5 Wrought</td> <td>7 Fiberglass</td> <td>9 Other (specify below)</td> </tr> <tr> <td>2 PVC</td> <td>4 ABS</td> <td>6 Asbestos-Cement</td> <td>8 Concrete Tile</td> <td>BRICK - LIMESTONE ROCKS...</td> </tr> </table> <p>Blank casing diameter...6.0...in. Was casing removed REMOVED pulled? Yes...X... No... If yes, how much...5.5... Casing height above or below land surface...66...in.</p>	1 Steel	3 RMP (SR)	5 Wrought	7 Fiberglass	9 Other (specify below)	2 PVC	4 ABS	6 Asbestos-Cement	8 Concrete Tile	BRICK - LIMESTONE ROCKS...
1 Steel	3 RMP (SR)	5 Wrought	7 Fiberglass	9 Other (specify below)							
2 PVC	4 ABS	6 Asbestos-Cement	8 Concrete Tile	BRICK - LIMESTONE ROCKS...							

6	GROUT PLUG MATERIAL: 1 Neat cement 2 Cement grout <u>3 Bentonite</u> 4 Other..... Grout Plug Intervals: From 5 ...ft. to 5.5 ...ft., From...ft. to...ft., From...ft. to...ft. What is the nearest source of possible contamination: - LOCATED IN VACANT LOTS <table border="0"> <tr> <td>1 Septic tank</td> <td>6 Seepage pit</td> <td>11 Fuel storage</td> <td>16 Other (specify below)</td> </tr> <tr> <td>2 Sewer lines</td> <td>7 Pit privy</td> <td>12 Fertilizer storage</td> <td>AUTO PARKING.....</td> </tr> <tr> <td>3 Watertight sewer lines</td> <td>8 Sewage lagoon</td> <td>13 Insecticide storage</td> <td></td> </tr> <tr> <td>4 Lateral lines</td> <td>9 Feedyard</td> <td>14 Abandoned water well</td> <td></td> </tr> <tr> <td>5 Cess Pool</td> <td>10 Livestock pens</td> <td>15 Oil well/Gas well</td> <td></td> </tr> </table> <p>Direction from well? W - NW..... How many feet? 25.....</p>	1 Septic tank	6 Seepage pit	11 Fuel storage	16 Other (specify below)	2 Sewer lines	7 Pit privy	12 Fertilizer storage	AUTO PARKING	3 Watertight sewer lines	8 Sewage lagoon	13 Insecticide storage		4 Lateral lines	9 Feedyard	14 Abandoned water well		5 Cess Pool	10 Livestock pens	15 Oil well/Gas well	
1 Septic tank	6 Seepage pit	11 Fuel storage	16 Other (specify below)																		
2 Sewer lines	7 Pit privy	12 Fertilizer storage	AUTO PARKING																		
3 Watertight sewer lines	8 Sewage lagoon	13 Insecticide storage																			
4 Lateral lines	9 Feedyard	14 Abandoned water well																			
5 Cess Pool	10 Livestock pens	15 Oil well/Gas well																			

FROM	TO	PLUGGING MATERIALS	
0	5	CLAY SILT	* AS FOUND - WELL HAD BEEN BACK FILLED WITH CLAY BASE MATERIAL WITH HAND PUMP IN PLACE - MATERIAL SETTLED SOME 5-6' - THIS TOP AREA BECAME TRASH COLLECTOR - PUMP AND PIPE WAS REMOVED TO 27' - TOP TRASH AND MATERIAL WAS REMOVED TO 13' - TD WAS ESTIMATED THROUGH THE PUMP PIPE - WALL OF WELL REMOVED TO 5.5' - PIPE HOLE FILLED WITH BENTONITE - 6" BENTONITE GROUT IN PLACE BACK FILL WITH CLAY - WITH ONE LOAD OF TOP SOIL FOR LOW GROUND AROUND WELL -
5	5.5	BENTONITE	
5.5	13	CLAY	
13	32?	CLAY	

7	CONTRACTOR'S OR LANDOWNER'S CERTIFICATION: This water well was plugged under my jurisdiction and was completed on (mo/day/year) 12-09-94 ... and this record is true to the best of my knowledge and belief. Kansas Water Well Contractor's License No. 479 This Water Well Record was completed on (mo/day/year) 01-07-95 under the business name of EBBERTS DRILLING by (signature) <i>Shawn Ebberts</i>
---	---

INSTRUCTIONS: Use typewriter or ball point pen. Please press firmly and print clearly. Please fill in blanks, underline or circle the correct answers. Send top three copies to Kansas Department of Health and Environment, Bureau of Water, Topeka, Kansas 66620-0001. Telephone: 913/296-3565. Send one to Water Well Owner and retain one for your records.