


1 LOCATION OF WATER WELL: Fraction SW SE Section Number 8 Township Number T 19 S Range Number R 11 EW  
 County: LYON SE 1/4 SE 1/4 SW 1/4

Distance and direction from nearest town or city street address of well if located within city?  
2611 W 50 - EMPORIA KS

2 WATER WELL OWNER: BLUESTEM FARM AND RANCH SUPPLY  
 RR#, St. Address, Box #: 2611 W 50 - EMPORIA KS 6690 ATT LEE NELSON Board of Agriculture, Division of Water Resources  
 City, State, ZIP Code: Application Number:

3 LOCATE WELL'S LOCATION WITH AN "X" IN SECTION BOX:

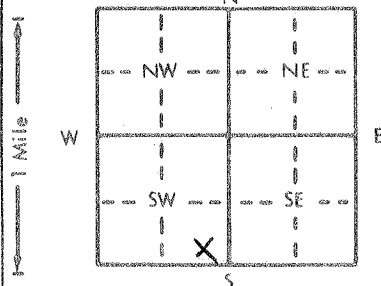

4 DEPTH OF COMPLETED WELL UNKNOWN 999 ft. ELEVATION: \_\_\_\_\_  
 Depth(s) Groundwater Encountered 1 UNKNOWN ft. 2. \_\_\_\_\_ ft. 3. \_\_\_\_\_ ft.  
 WELL'S STATIC WATER LEVEL UNKNOWN 999 below land surface measured on mo/day/yr 10-31-74

Pump test data: Well water was \_\_\_\_\_ ft. after \_\_\_\_\_ hours pumping \_\_\_\_\_ gpm  
 Est. Yield NA gpm: Well water was \_\_\_\_\_ ft. after \_\_\_\_\_ hours pumping \_\_\_\_\_ gpm  
 Bore Hole Diameter 60+ in. to UNKNOWN in. to \_\_\_\_\_ ft.  
 WELL WATER TO BE USED AS: 5 Public water supply 8 Air conditioning 11 Injection well  
 1 Domestic 3 Feedlot 6 Oil field water supply 9 Dewatering 12 Other (Specify below) PLUGGED  
 2 Irrigation 4 Industrial 7 Lawn and garden only 10 Monitoring well  
 Was a chemical/bacteriological sample submitted to Department? Yes \_\_\_\_\_ No X; If yes, mo/day/yr sample was submitted \_\_\_\_\_  
 Water Well Disinfected? Yes X No \_\_\_\_\_

5 TYPE OF BLANK CASING USED: 5 Wrought iron 8 Concrete tile CASING JOINTS: Glued \_\_\_\_\_ Clamped \_\_\_\_\_  
 1 Steel 3 RMP (SR) 6 Asbestos-Cement 9 Other (specify below) Welded \_\_\_\_\_  
 2 PVC 4 ABS 7 Fiberglass LIME STONE ROCKS Threaded \_\_\_\_\_

Blank casing diameter 60 in. to UNKNOWN ft., Dia. \_\_\_\_\_ in. to \_\_\_\_\_ ft., Dia. \_\_\_\_\_ in. to \_\_\_\_\_ ft.  
 Casing height above land surface \* in., weight NA lbs./ft. Wall thickness or gauge No. \_\_\_\_\_

TYPE OF SCREEN OR PERFORATION MATERIAL: NA\* 7 PVC 10 Asbestos-cement  
 1 Steel 3 Stainless steel 5 Fiberglass 8 RMP (SR) 11 Other (specify) LIME STONE ROCKS  
 2 Brass 4 Galvanized steel 6 Concrete tile 9 ABS 12 None used (open hole)

SCREEN OR PERFORATION OPENINGS ARE: 5 Gauzed wrapped 8 Saw cut 11 None (open hole)  
 1 Continuous slot 3 Mill slot 6 Wire wrapped 9 Drilled holes  
 2 Louvered shutter 4 Key punched 7 Torch cut 10 Other (specify) LIME STONE ROCKS

SCREEN-PERFORATED INTERVALS: From UA ft. to \_\_\_\_\_ ft., From \_\_\_\_\_ ft. to \_\_\_\_\_ ft.  
 From \_\_\_\_\_ ft. to \_\_\_\_\_ ft., From \_\_\_\_\_ ft. to \_\_\_\_\_ ft.  
 GRAVEL PACK INTERVALS: From NA ft. to \_\_\_\_\_ ft., From \_\_\_\_\_ ft. to \_\_\_\_\_ ft.  
 From \_\_\_\_\_ ft. to \_\_\_\_\_ ft., From \_\_\_\_\_ ft. to \_\_\_\_\_ ft.

6 GROUT MATERIAL: 1 Neat cement 2 Cement grout 3 Bentonite 4 Other \_\_\_\_\_  
 Grout Intervals: From S ft. to TD ft., From \_\_\_\_\_ ft. to \_\_\_\_\_ ft., From \_\_\_\_\_ ft. to \_\_\_\_\_ ft.

What is the nearest source of possible contamination:  
 1 Septic tank 4 Lateral lines 7 Pit privy 10 Livestock pens 14 Abandoned water well  
 2 Sewer lines 5 Cess pool 8 Sewage lagoon 11 Fuel storage 15 Oil well/Gas well  
 3 Watertight sewer lines 6 Seepage pit 9 Feedyard 12 Fertilizer storage 16 Other (specify below)  
 13 Insecticide storage

Direction from well? N-NE How many feet? 350+

FROM	TO	LITHOLOGIC LOG	FROM	TO	PLUGGING INTERVALS
*		<u>GROUND WATER SHOULD BE APPROXIMATELY 30-32' IN THIS LOCATION</u>			<u>N B.F.R.S BUILD.</u>
		<u>WELL HAD BEEN BACK FILLED WITH BROKEN CONCRETE FLAG STONES - WITH 7-2X4S 5' LONG - 2.5' FROM TOP - THESE WERE JACKED OUT</u>			<u>WEST SIDE DOWN</u>
		<u>THE SOIL CAVE IN OR TOP 3" WAS REMOVED AND THEN 2 YDS OF SLURRY WAS PUT IN PLACE THIS FILLED THE CAVITY TO -2' FROM G.L.</u>			<u>WELL</u>
		<u>THE SHRINK DROPPED IT BACK TO -5' FROM G.L.</u>			<u>112'</u>
		<u>11-03-94 - CUT AND FILL OF SITE AREA RAISED</u>			<u>CENTER STEEL METAL SHED SUPPORT</u>
		<u>THE G.L. AT THE WELL APPROX 2 MORE FEET</u>			<u>REF-PLUG IN PLACE W/ 10-30-94 D. TAYLOR B.O.F.W</u>

7 CONTRACTOR'S OR LANDOWNER'S CERTIFICATION: This water well was (1) constructed, (2) reconstructed, or (3) plugged under my jurisdiction and was completed on (mo/day/year) 10-31-94 and this record is true to the best of my knowledge and belief. Kansas Water Well Contractor's License No. 479 This Water Well Record was completed on (mo/day/yr) 11-04-94 under the business name of EBBERTS DRILLING by (signature) Gregory Ebberts