


1 LOCATION OF WATER WELL: Fraction NE 1/4 SW 1/4 SE 1/4 Section Number 8 Township Number T 19 S Range Number R 11 E
 County: Lyon

Distance and direction from nearest town or city street address of well if located within city?
2606 West Highway 50, Emporia, KS MW-1
 2 WATER WELL OWNER: StS ~~Service~~ Oil & Propane Co
 RR#, St. Address, Box #: 2606 West Highway 50 Board of Agriculture, Division of Water Resources
 City, State, ZIP Code: Emporia, KS 66801 Application Number:

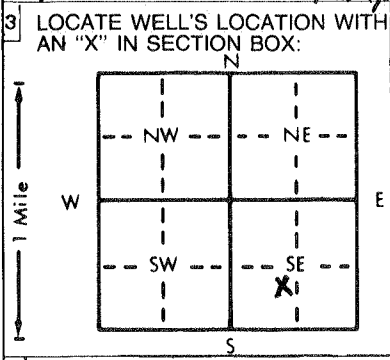

4 DEPTH OF COMPLETED WELL... 29.0 ft. ELEVATION:
 Depth(s) Groundwater Encountered 1. 1.8 ft. 2. ft. 3. ft.
 WELL'S STATIC WATER LEVEL ... 17.24 ft. below land surface measured on mo/day/yr ... 2/14/95
 Pump test data: Well water was ft. after hours pumping gpm
 Est. Yield gpm: Well water was ft. after hours pumping gpm
 Bore Hole Diameter in. to ft., and in. to ft.
 WELL WATER TO BE USED AS: 5 Public water supply 8 Air conditioning 11 Injection well
 1 Domestic 3 Feedlot 6 Oil field water supply 9 Dewatering 12 Other (Specify below)
 2 Irrigation 4 Industrial 7 Lawn and garden only 0 Monitoring well
 Was a chemical/bacteriological sample submitted to Department? Yes..... No.....; If yes, mo/day/yr sample was submitted
 Water Well Disinfected? Yes No

5 TYPE OF BLANK CASING USED: 5 Wrought iron 8 Concrete tile CASING JOINTS: Glued Clamped
 1 Steel 3 RMP (SR) 6 Asbestos-Cement 9 Other (specify below) Welded
0 PVC 4 ABS 7 Fiberglass Threaded
 Blank casing diameter ... 2 in. to ... 14.0 ft., Dia in. to ft., Dia in. to ft.
 Casing height above land surface 0 in., weight lbs./ft. Wall thickness or gauge No.
 TYPE OF SCREEN OR PERFORATION MATERIAL: 0 PVC 10 Asbestos-cement
 1 Steel 3 Stainless steel 5 Fiberglass 8 RMP (SR) 11 Other (specify)
 2 Brass 4 Galvanized steel 6 Concrete tile 9 ABS 12 None used (open hole)
 SCREEN OR PERFORATION OPENINGS ARE: 5 Gauzed wrapped 8 Saw cut 11 None (open hole)
 1 Continuous slot 0 Mill slot 6 Wire wrapped 9 Drilled holes
 2 Louvered shutter 4 Key punched 7 Torch cut 10 Other (specify)
 SCREEN-PERFORATED INTERVALS: From ... 14.0 ft. to ... 29.0 ft., From ft. to ft.
 From ft. to ft., From ft. to ft.
 GRAVEL PACK INTERVALS: From ... 13.0 ft. to ... 29.0 ft., From ft. to ft.
 From ft. to ft., From ft. to ft.

6 GROUT MATERIAL: 1 Neat cement 0 Cement grout 0 Bentonite 4 Other
 Grout Intervals: From ... 0 ft. to ... 11.0 ft., From ... 11.0 ft. to ... 13.0 ft., From ft. to ft.
 What is the nearest source of possible contamination:
 1 Septic tank 4 Lateral lines 7 Pit privy 11 Fuel storage 14 Abandoned water well
 2 Sewer lines 5 Cess pool 8 Sewage lagoon 12 Fertilizer storage 15 Oil well/Gas well
 3 Watertight sewer lines 6 Seepage pit 9 Feedyard 13 Insecticide storage 16 Other (specify below)

Direction from well? East How many feet? 10

FROM	TO	LITHOLOGIC LOG	FROM	TO	PLUGGING INTERVALS
0'	1.5'	Gravel (fill)			
1.5'	4.0'	clay w/ silt, dark brown			
4.0'	29.0'	clay, stiff, light brown, w/ gravel			

7 CONTRACTOR'S OR LANDOWNER'S CERTIFICATION: This water well was 0 constructed, (2) reconstructed, or (3) plugged under my jurisdiction and was completed on (mo/day/year) ... 2/7/95 and this record is true to the best of my knowledge and belief. Kansas Water Well Contractor's License No. ... 438 This Water Well Record was completed on (mo/day/yr) ... 2/21/95 under the business name of Kansas City Testing Lab by (signature) Charles H. Humpal