


1 LOCATION OF WATER WELL: County: **LYON** Fraction: **NW 1/4 SW 1/4 NW 1/4** Section Number: **35** Township Number: **T 19 S** Range Number: **R 12 EW**

Distance and direction from nearest town or city street address of well if located within city?
1/4 mile West & 3/4 mile South of Neosho Rapids

2 WATER WELL OWNER: **Robert Wellnitz**
 RR#, St. Address, Box #: **RT 1**
 City, State, ZIP Code: **Neosho Rapids, Ks**
 Board of Agriculture, Division of Water Resources
 Application Number:

3 LOCATE WELL'S LOCATION WITH AN "X" IN SECTION BOX:

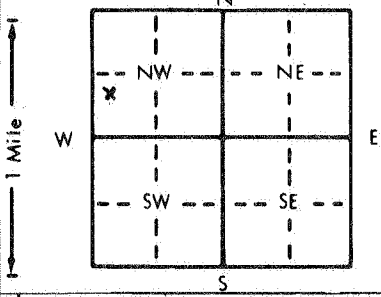

4 DEPTH OF COMPLETED WELL: **38** ft. ELEVATION:
 Depth(s) Groundwater Encountered 1. **27** ft. 2. ft. 3. ft.
 WELL'S STATIC WATER LEVEL: **10** ft. below land surface measured on mo/day/yr **Feb 24 92**

Pump test data: Well water was ft. after hours pumping gpm
 Est. Yield **10** gpm: Well water was ft. after hours pumping gpm
 Bore Hole Diameter: **9** in. to **34** ft., and **6 1/2** in. to **38** ft.

WELL WATER TO BE USED AS:
 1 Domestic 3 Feedlot 6 Oil field water supply 9 Dewatering 12 Other (Specify below)
 2 Irrigation 4 Industrial 7 Lawn and garden only 10 Monitoring well

Was a chemical/bacteriological sample submitted to Department? Yes No
 If yes, mo/day/yr sample was submitted
 Water Well Disinfected? Yes No

5 TYPE OF BLANK CASING USED:
 1 Steel 3 RMP (SR) 6 Asbestos-Cement 9 Other (specify below)
 2 PVC 4 ABS 7 Fiberglass

CASING JOINTS: Glued Clamped Welded Threaded
 Blank casing diameter: **5** in. to **27** ft., Dia. in. to ft., Dia. in. to ft.
 Casing height above land surface: **36** in., weight lbs./ft. Wall thickness or gauge No. **SDR-26**

TYPE OF SCREEN OR PERFORATION MATERIAL:
 1 Steel 3 Stainless steel 5 Fiberglass 7 PVC 10 Asbestos-cement
 2 Brass 4 Galvanized steel 6 Concrete tile 8 RMP (SR) 11 Other (specify)

SCREEN OR PERFORATION OPENINGS ARE:
 1 Continuous slot 3 Mill slot 6 Wire wrapped 8 Saw cut 11 None (open hole)
 2 Louvered shutter 4 Key punched 7 Torch cut 9 Drilled holes 10 Other (specify)

SCREEN-PERFORATED INTERVALS: From **27** ft. to **38** ft., From ft. to ft., From ft. to ft.
 GRAVEL PACK INTERVALS: From **23** ft. to **38** ft., From ft. to ft., From ft. to ft.

6 GROUT MATERIAL: 1 Neat cement 2 Cement grout 3 Bentonite 4 Other
 Grout Intervals: From **3** ft. to **23** ft., From ft. to ft., From ft. to ft.

What is the nearest source of possible contamination:
 1 Septic tank 4 Lateral lines 7 Pit privy 10 Livestock pens 14 Abandoned water well
 2 Sewer lines 5 Cess pool 8 Sewage lagoon 11 Fuel storage 15 Oil well/Gas well
 3 Watertight sewer lines 6 Seepage pit 9 Feedyard 12 Fertilizer storage 16 Other (specify below)
 13 Insecticide storage

Direction from well? **South** How many feet? **300**

FROM	TO	LITHOLOGIC LOG	FROM	TO	PLUGGING INTERVALS
0	4	Top soil B/R			
4	8	Clay TAN			
8	24	Clay SANDY			
24	32	SAND & Gravel			
32	38	Shale Gray			

7 CONTRACTOR'S OR LANDOWNER'S CERTIFICATION: This water well was (1) constructed, (2) reconstructed, or (3) plugged under my jurisdiction and was completed on (mo/day/year) **Feb 24 92** and this record is true to the best of my knowledge and belief. Kansas Water Well Contractor's License No. **218** This Water Well Record was completed on (mo/day/yr) **Feb 24 92** under the business name of **ZINN Water Well Dnlg** by (signature) **Joseph A. Zinn**