


LOCATION OF WATER WELL: Fraction NE 1/4 SW 1/4 NE 1/4 Section Number 29 Township Number T 19 S Range Number R 13 E

County: Lyon Distance and direction from nearest town or city street address of well if located within city?  
Commercial St. Neosho Rapids

WATER WELL OWNER: Virgil Wamser RR# RR-1 City, State, ZIP Code: Neosho Rapids 66864 Board of Agriculture, Division of Water Resources Application Number: NA

LOCATE WELL'S LOCATION WITH AN "X" IN SECTION BOX: DEPTH OF COMPLETED WELL: 49 ft. ELEVATION: 40-46 ft.

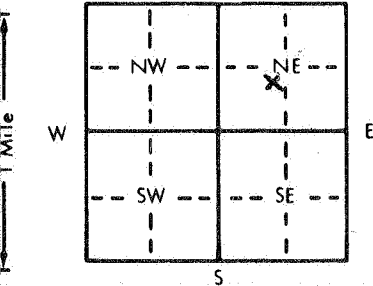

Depth(s) Groundwater Encountered 1. 25 ft. 2. 40-46 ft. 3. 8-5-83 ft.  
WELL'S STATIC WATER LEVEL 25 ft. below land surface measured on mo/day/yr 8-5-83  
Bore Hole Diameter 10 in. to 49 ft., and 10 in. to 49 ft.  
WELL WATER TO BE USED AS: 5 Public water supply 8 Air conditioning 11 Injection well  
 Domestic 3 Feedlot 6 Oil field water supply 9 Dewatering 12 Other (Specify below)  
2 Irrigation 4 Industrial 7 Lawn and garden only 10 Observation well  
Was a chemical/bacteriological sample submitted to Department? Yes.....No.....; If yes, mo/day/yr sample was submitted  
Water Well Disinfected? Yes No

TYPE OF BLANK CASING USED: 1 Steel 3 RMP (SR) 5 Wrought iron 8 Concrete tile CASING JOINTS: Glued  Clamped  
 PVC 4 ABS 6 Asbestos-Cement 9 Other (specify below) Welded  
2 Brass 7 Fiberglass Threaded  

TYPE OF SCREEN OR PERFORATION MATERIAL: 1 Steel 3 Stainless steel 5 Fiberglass  PVC 10 Asbestos-cement  
2 Brass 4 Galvanized steel 6 Concrete tile 8 RMP (SR) 11 Other (specify)  
7 Torch cut 12 None used (open hole)

SCREEN OR PERFORATION OPENINGS ARE: 1 Continuous slot 3 Mill slot 5 Gauzed wrapped  Saw cut 11 None (open hole)  
2 Louvered shutter 4 Key punched 6 Wire wrapped 9 Drilled holes  
7 Torch cut 10 Other (specify)

SCREEN-PERFORATED INTERVALS: From 40 ft. to 49 ft., From 40 ft. to 49 ft., From 40 ft. to 49 ft., From 40 ft. to 49 ft.  
GRAVEL PACK INTERVALS: From 13 ft. to 49 ft., From 13 ft. to 49 ft., From 13 ft. to 49 ft., From 13 ft. to 49 ft.

GROUT MATERIAL:  Neat cement 2 Cement grout 3 Bentonite 4 Other  
Grout Intervals: From 0 ft. to 13 ft., From 0 ft. to 13 ft., From 0 ft. to 13 ft., From 0 ft. to 13 ft.  
What is the nearest source of possible contamination: 1 Septic tank 4 Lateral lines 7 Pit privy 10 Livestock pens 14 Abandoned water well  
2 Sewer lines 5 Cess pool 8 Sewage lagoon 11 Fuel storage 15 Oil well/Gas well  
 Watertight sewer lines 6 Seepage pit 9 Feedyard 12 Fertilizer storage 16 Other (specify below)  
13 Insecticide storage  
Direction from well? North West How many feet? 50

FROM	TO	LITHOLOGIC LOG	FROM	TO	LITHOLOGIC LOG
0	4	TS Blcks.			
4	15	Cl Brn.			
15	40	CL ML w sand Lt Brn.			
40	47	Sand & Gravel			
47	49	Sh Gray. Med.			

CONTRACTOR'S OR LANDOWNER'S CERTIFICATION: This water well was  constructed, (2) reconstructed, or (3) plugged under my jurisdiction and was completed on (mo/day/year) 8-5-83 and this record is true to the best of my knowledge and belief. Kansas Water Well Contractor's License No. 203 This Water Well Record was completed on (mo/day/yr) 8-6-83 under the business name of McNee Drilling & Metals by (signature) J. C. McNee

INSTRUCTIONS: Use typewriter or ball point pen, PLEASE PRESS FIRMLY and PRINT clearly. Please fill in blanks, underline or circle the correct answers. Send top three copies to Kansas Department of Health and Environment, Division of Environment, Environmental Geology Section, Topeka, KS 66620. Send one to WATER WELL OWNER and retain one for your records.