


MW-5

1 LOCATION OF WATER WELL: Fraction **SE 1/4 SE 1/4 SE 1/4** Section Number **9** Township Number **T 19 S** Range Number **R 14 EW**
 County: **Coffey**

Distance and direction from nearest town or city street address of well if located within city?
1/4 mile South of Lebo

2 WATER WELL OWNER: **Lebo Implement Attn: John Evans** Board of Agriculture, Division of Water Resources
 RR#, St. Address, Box #: **P.O. Box 67, Lebo, Ks 66856** Application Number: _____
 City, State, ZIP Code: _____

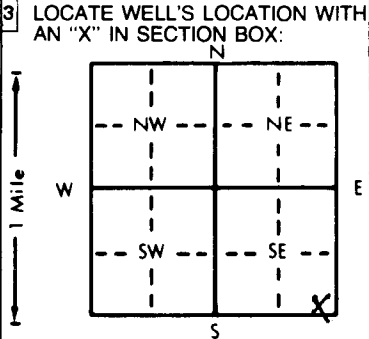

4 DEPTH OF COMPLETED WELL: **15** ft. ELEVATION: _____
 Depth(s) Groundwater Encountered 1. **11.0** ft. 2. _____ ft. 3. _____ ft.
 WELL'S STATIC WATER LEVEL **4.73** ft. below land surface measured on **mo/day/yr 9/11/97**
 Pump test data: Well water was _____ ft. after _____ hours pumping _____ gpm
 Est. Yield _____ gpm: Well water was _____ ft. after _____ hours pumping _____ gpm
 Bore Hole Diameter **8.625** in. to **15** ft., and _____ in. to _____ ft.
 WELL WATER TO BE USED AS:
 5 Public water supply 8 Air conditioning 11 Injection well
 1 Domestic 3 Feedlot 6 Oil field water supply 9 Dewatering 12 Other (Specify below)
 2 Irrigation 4 Industrial 7 Lawn and garden only Monitoring well
 Was a chemical/bacteriological sample submitted to Department? Yes _____ No If yes, mo/day/yr sample was sub-
 mitted _____ Water Well Disinfected? Yes _____ No _____

5 TYPE OF BLANK CASING USED:
 1 Steel 3 RMP (SR) 5 Wrought iron 8 Concrete tile CASING JOINTS: Glued _____ Clamped _____
 PVC 4 ABS 7 Fiberglass 9 Other (specify below) Welded _____
 Blank casing diameter **2** in. to **5** ft., Dia _____ in. to _____ ft., Dia _____ in. to **X** ft.
 Casing height above land surface **FLUSH** in., weight **SCH 40 PVC** lbs./ft. Wall thickness or gauge No. _____
 TYPE OF SCREEN OR PERFORATION MATERIAL:
 1 Steel 3 Stainless steel 5 Fiberglass 8 RMP (SR) 10 Asbestos-cement
 2 Brass 4 Galvanized steel 6 Concrete tile 9 ABS 11 Other (specify) _____
 12 None used (open hole) _____
 SCREEN OR PERFORATION OPENINGS ARE:
 1 Continuous slot Mill slot 5 Gauzed wrapped 8 Saw cut 11 None (open hole)
 2 Louvered shutter 4 Key punched 6 Wire wrapped 9 Drilled holes
 7 Torch cut 10 Other (specify) _____
 SCREEN-PERFORATED INTERVALS: From **15** ft. to **5** ft., From _____ ft. to _____ ft.
 From _____ ft. to _____ ft., From _____ ft. to _____ ft.
 GRAVEL PACK INTERVALS: From **15** ft. to **4** ft., From _____ ft. to _____ ft.
 From _____ ft. to _____ ft., From _____ ft. to _____ ft.

6 GROUT MATERIAL: 1 Neat cement Cement grout Bentonite 4 Other _____
 Grout Intervals: From **4** ft. to **2** ft. From **2** ft. to **0** ft. From _____ ft. to _____ ft.
 What is the nearest source of possible contamination:
 1 Septic tank 4 Lateral lines 7 Pit privy 10 Livestock pens ~~14~~ Abandoned water-well
 2 Sewer lines 5 Cess pool 8 Sewage lagoon 11 Fuel storage 15 Oil well/Gas well
 3 Watertight sewer lines 6 Seepage pit 9 Feedyard 12 Fertilizer storage 16 Other (specify below)
 13 Insecticide storage **CONTAMINATED SITE**
 Direction from well? _____ How many feet? _____

FROM	TO	LITHOLOGIC LOG	FROM	TO	PLUGGING INTERVALS
GL	1.00	Soil			
1.00	5.50	Silty Clay (CL)			
5.50	15.00	Silt			
15.00	TD	End of Borehole			

7 CONTRACTOR'S OR LANDOWNER'S CERTIFICATION: This water well was constructed, reconstructed, or plugged under my jurisdiction and was completed on (mo/day/year) **9/10/97** and this record is true to the best of my knowledge and belief. Kansas Water Well Contractor's License No. **585** This Water Well Record was completed on (mo/day/yr) **9/25/97** under the business name of **Associated Environmental, Inc** by (signature) *David P. L...*

OFFICE USE ONLY
T
R
EW
SEC.