


084

1 LOCATION OF WATER WELL: County: Coffey Fraction: NE 1/4 NE 1/4 NE 1/4 Section Number: 23 Township Number: T 19 S Range Number: R 16 EW

Distance and direction from nearest town or city street address of well if located within city?
1st & Pierson, Waverly, Ks.

2 WATER WELL OWNER: Dave Lybarger/Lybarger Oil RR#, St. Address, Box #: P.O. Box 99 City, State, ZIP Code: Garnett, Ks. 66032 Board of Agriculture, Division of Water Resources Application Number:

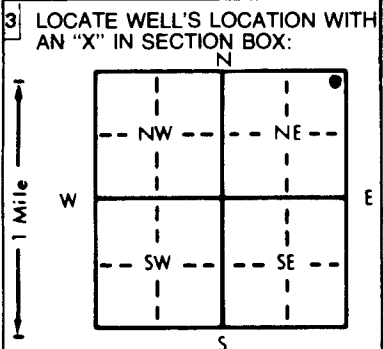

4 DEPTH OF COMPLETED WELL: 14'6" ft. ELEVATION: Depth(s) Groundwater Encountered: 1. 7' ft. 2. ft. 3. ft. WELL'S STATIC WATER LEVEL: 5.75 ft. below land surface measured on mo/day/yr: 6-19-96 Pump test data: Well water was ft. after hours pumping gpm Est. Yield gpm: Well water was ft. after hours pumping gpm Bore Hole Diameter: 8 1/2" in. to 8" ft., and 5 1/2" in. to 14'6" ft. WELL WATER TO BE USED AS: 5 Public water supply 8 Air conditioning 11 Injection well 1 Domestic 3 Feedlot 6 Oil field water supply 9 Dewatering 12 Other (Specify below) 2 Irrigation 4 Industrial 7 Lawn and garden only 10 Monitoring well observation well Was a chemical/bacteriological sample submitted to Department? Yes No X; If yes, mo/day/yr sample was submitted Water Well Disinfected? Yes No

5 TYPE OF BLANK CASING USED: 1 Steel 3 RMP (SR) 5 Wrought iron 8 Concrete tile CASING JOINTS: Glued Clamped 2 PVC 4 ABS 6 Asbestos-Cement 9 Other (specify below) Welded Threaded X Blank casing diameter: 2.375 in. to 6.6" ft., Dia. in. to sch 13 ft. Casing height above land surface: Flush Mt. in., weight lbs./ft. Wall thickness or gauge No. sch 40 TYPE OF SCREEN OR PERFORATION MATERIAL: 1 Steel 3 Stainless steel 5 Fiberglass 8 RMP (SR) 10 Asbestos-cement 2 Brass 4 Galvanized steel 6 Concrete tile 9 ABS 11 Other (specify) 12 None used (open hole) SCREEN OR PERFORATION OPENINGS ARE: 1 Continuous slot 3 Mill slot 5 Gauzed wrapped 8 Saw cut 11 None (open hole) 2 Louvered shutter 4 Key punched 6 Wire wrapped 9 Drilled holes 10 Other (specify) SCREEN-PERFORATED INTERVALS: From 14'6" ft. to 6'6" ft., From ft. to ft. GRAVEL PACK INTERVALS: From 14'6" ft. to 6' ft., From ft. to ft.

6 GROUT MATERIAL: 1 Neat cement 2 Cement grout 3 Bentonite 4 Other Grout Intervals: From 6 ft. to 4' ft., From 4' ft. to 0' ft. What is the nearest source of possible contamination: 1 Septic tank 4 Lateral lines 7 Pit privy 10 Livestock pens 14 Abandoned water well 2 Sewer lines 5 Cess pool 8 Sewage lagoon 11 Fuel storage 15 Oil well/Gas well 3 Watertight sewer lines 6 Seepage pit 9 Feedyard 12 Fertilizer storage 16 Other (specify below) 13 Insecticide storage Direction from well? North How many feet? 10'

FROM	TO	LITHOLOGIC LOG	FROM	TO	PLUGGING INTERVALS
0	.50	Concrete			
.50	3	Blk silty clay, moist, strong odor.			
3	7	Red brn silty clay w/ blk clay mottling, mod-strong odor, moist, low-med plasticity.			
7	10	Weathered limestone-limestone, fractured, thinly bedded.			
10	14'6"	Gray crystalline limestone, hard, dry, odor.			
F.M. OK'd by Don Taylor					

7 CONTRACTOR'S OR LANDOWNER'S CERTIFICATION: This water well was (1) constructed (2) reconstructed, or (3) plugged under my jurisdiction and was completed on (mo/day/year) 6-19-96 and this record is true to the best of my knowledge and belief. Kansas Water Well Contractor's License No. 539 This Water Well Record was completed on (mo/day/yr) 6-26-96 under the business name of JB Environmental Drilling by (signature) James Beebe

OFFICE USE ONLY T R EW SEC. 1/4 1/4 1/4